

Referral Agency Response Report**Page 1 of 4****Project Name:** Pinery Filing 30A, Tract F**Project File #:** LE2024-027**Date Sent:** 11/12/2024**Date Due:** 11/26/2024

Agency	Date Received	Agency Response	Response Resolution
Addressing Analyst	11/18/2024	No Comment	No action necessary
Assessor	11/19/2024	No Comment	No action necessary
AT&T Long Distance - ROW	11/13/2024	Received: This is in response to your eReferral with a utility map showing any buried AT&T Long Line Fiber Optics near Democrat Road Franktown, Colorado. The Earth map shows the project area in red. Based on the address and/or map you provided, there should be NO conflicts with the AT&T Long Lines, as we do not have facilities in that area. Ann Barnowski Clearwater Consulting Group Inc 120 9th Avenue South Suite 140, Nampa, ID 83651 Annb@cwc64.com	No action necessary
Black Hills Energy		No Response Received	No action necessary
Building Services	11/22/2024	Received: Permit is required, please visit Douglas County's web site for requirements and contact 303-660-7497 if you have any questions.	Comments forwarded to applicant to address.
CenturyLink	11/20/2024	Received: We have received your request for an Encroachment and have set up a Lumen project accordingly. Your project number is P864060 and it should be referenced in all emails sent in for review. Your project owner is Richard Hollis and they can be reached by email at Richard.Hollis@lumen.com with any questions that you may have regarding this project. Eryn Ogden, Project Coordinator Faulk & Foster 214 Expo Circle, Suite 7 West Monroe, LA 71291 Eryn.Ogden@lumen.com	No action necessary

Project Name: Pinery Filing 30A, Tract F**Project File #:** LE2024-027**Date Sent:** 11/12/2024**Date Due:** 11/26/2024

Agency	Date Received	Agency Response	Response Resolution
Comcast		No Response Received	No action necessary
CORE Electric Cooperative	11/20/2024	No Comment	No action necessary
Engineering Services	11/26/2024	<p>Received:</p> <p>General Comments Summary:</p> <p>Please submit construction drawings and plans (including GESC Plans). These are not required for the approval of the L&E but will be required prior to construction.</p> <p>Please submit them to Carol LeMaire (clemaire@douglas.co.us)</p> <p>Drainage Comments Summary:</p> <p>It appears that an older Phase III Drainage Report was used than the most recent which included a detention pond around the building to the northeast. Please reassess and amend the letter per the most recent Phase III Drainage Report (see attached). With this, please either show that the detention and/or water quality for this proposed site is being accounted for in the detention pond around the building to the northeast, or that a grass buffer or swale is being provided per the Mile High Flood District criteria. Please provide all calculations for either case as part of the report.</p> <p>Traffic Comments Summary:</p> <p>Please discuss in the narrative the number of trips that the site currently receives and the anticipated number of trips that the site will receive and discuss the frequency. With the next submittal, please enclose a written response to these comments. Jacob Gabel, Development Review Engineer</p>	Comments forwarded to applicant to address.

Referral Agency Response Report**Page 3 of 4****Project Name:** Pinery Filing 30A, Tract F**Project File #:** LE2024-027**Date Sent:** 11/12/2024**Date Due:** 11/26/2024

Agency	Date Received	Agency Response	Response Resolution
High Prairie Farms HOA		No Response Received	No action necessary
High Prairie Farms Metro District		No Response Received	No action necessary
Mile High Flood District		No Response Received	No action necessary
Misty Pines HOA	11/21/2024	No Comment	No action necessary
Office of Emergency Management		No Response Received	No action necessary
Pinery Water and Wastewater District		No Response Received	No action necessary
Sheriff's Office	11/26/2024	Received: This was reviewed by Deputy Jeff Pelle with the Douglas County Sheriff's Office. I have no comments or concerns at this time for the project.	No action necessary
Sheriff's Office E911		No Response Received	No action necessary
South Metro Fire Rescue	11/14/2024	Received: South Metro Fire Rescue (SMFR) has reviewed the provided documents and has no objection to the proposed Location and Extent. Applicants and Contractors are encouraged to contact SMFR regarding the applicable permit requirements for the proposed project.	No action necessary
The Pinery HOA	11/26/2024	Received: The Pinery HOA appreciates the attention to blend the buildings colors in with the surrounding environment and thoughtful placement to reduce the removal of trees.	No action necessary
Timbers At The Pinery Filing 23A HOA		No Response Received	No action necessary
Timbers At The Pinery Filing 23B HOA		No Response Received	No action necessary

Referral Agency Response Report**Page 4 of 4****Project Name:** Pinery Filing 30A, Tract F**Project File #:** LE2024-027**Date Sent:** 11/12/2024**Date Due:** 11/26/2024

Agency	Date Received	Agency Response	Response Resolution
Timbers HOA	11/26/2024	<p>Received:</p> <p>The Timbers T30A HOA does not object to the construction of the building per the particulars they provided to the county in their submission. We do however have one request. If at all possible, if some additional native trees could be planted between the HPFMD buildings and the detention swale, it would provide a layer of additional screening for our residents.</p> <p>Thank you, Ed Likman T30A HOA President 201-715-8658 edlikman@gmail.com</p>	Comments forwarded to applicant to address.
Xcel Energy-Right of Way & Permits	11/18/2024	<p>Received:</p> <p>Public Service Company of Colorado's (PSCo) Right of Way & Permits Referral Desk has reviewed the documents for the above-mentioned project and currently has no apparent conflict. As a safety precaution, PSCo would like to remind the developer to call the Utility Notification Center by dialing 811 for utility locates prior to construction.</p> <p>Violeta Ciocanu (Chokanu) Right of Way and Permits Public Service Company of Colorado dba Xcel Energy Office: 303-285-6612 – Email: violeta.ciocanu@xcelenergy.com</p>	No action necessary

REFERRAL RESPONSE REQUEST – LOCATION AND EXTENTDate sent: November 12, 2024Comments due by: November 26, 2024**Project Name:** *High Prairie Farms Metro District - Location and Extent***Project File #:** **LE2024-027**

Project Summary: High Prairie Farms Metro District requests approval of a Location and Extent for the construction of a new maintenance building located near the northeast corner of S. Pinery Pkwy and Democrat Road SPN: 2347-182-05-001.

Information on the identified development proposal located in Douglas County is enclosed. Please review and comment in the space provided.

<input type="checkbox"/> No Comment	
<input type="checkbox"/> Please be advised of the following concerns: <hr/> <hr/> <hr/>	
<input checked="" type="checkbox"/> See letter attached for detail.	
Agency: PW - Engineering	Phone #: (303) 660-7490
Your Name: Jacob Gabel <i>(please print)</i>	Your Signature: 
	Date: 11/26/2024

A public hearing on this request will be held before the Douglas County Planning Commission on **Monday, December 2, 2024, at 6:00 pm; located at 100 Third Street, Castle Rock, CO 80104 in the Commissioner's Hearing Room.**

Sincerely,

Carolyn Washee-Freeland

Carolyn Washee-Freeland, AICP
Senior Planner
303-660-7460
cfreeland@douglas.co.us

Enclosure

MEMORANDUM

To: Carolyn Washee-Freeland, Senior Planner
CC: Matt Miller, High Prairie Farms Metro District
From: Jacob Gabel, Development Review Engineer
Date: 11/26/2024

RE: Pinery Filing 30A, Tract F Maintenance Building: LE2024-027: DV2024-481

Initial Submittal: 11-13-2024
1st Engineering response letter: 11-26-2024

The Douglas County Department of Public Works Engineering has reviewed the Pinery Filing 30A, Tract F Maintenance Building Project and has the following comments:

General

1. Please submit any construction drawings and plans (including GESC Plans). These are not required for the approval of the L&E but will be required prior to construction.
 - a. Please note that the general process for approval of plans and permits is that once any plans are completed for this project, please submit them to Carol LeMaire (clemaire@douglas.co.us) with the DV# as part of the subject line. Once received, we will review them (usually 14 days, though this could be shorter or longer dependent on the project or our current workload), and send comments if there are any outstanding items or request final plans if there are no changes to be made. Once the plans are approved and fees are paid for, we will send the plans back to you. From there, please submit the GESC Permit to Carol LeMaire along with the approved plan and send any ROW Use and/or Construction Permits, Temporary Access Permits, etc., to Engineering Permits and Inspections (engpermits@douglas.co.us). Once the GESC Permit is approved you will receive an email to schedule a preconstruction meeting. Once this meeting has been completed with our inspectors, they will sign off on the permit and construction can commence when you have the approved permit in hand.

Drainage Letter

2. It appears that an older Phase III Drainage Report was used than the most recent which included a detention pond around the building to the northeast. Please reassess and amend the letter per the most recent Phase III Drainage Report (see attached). With this, please either show that the detention and/or water quality for this proposed site is being accounted for in the detention pond around the building to the northeast, or that a grass buffer or swale is being provided per the Mile High Flood District criteria. Please provide all calculations for either case as part of the report.

Traffic Letter

3. Please discuss in the narrative the number of trips that the site currently receives and the anticipated number of trips that the site will receive and discuss the frequency.

With the next submittal, please enclose a written response to these comments. Please let me know if you have any questions.

**THE PINERY
HIGH PRAIRIE FARMS MAINTENANCE FACILITY
PHASE III DRAINAGE REPORT**

for

**High Prairie Metro District
c/o Clifton Gunderson**

**Contact: Kenneth Black
Manager
6399 So. Fiddler's Green Circle, Suite 100
Greenwood Village, CO 80111
303-472-8120**


by

**Nolte Associates, Inc.
8000 South Chester Street, Suite 200
Centennial, Colorado 80112
(303) 220-6400**

*August 2007
Revised February 2008
Revised March 2008*

CERTIFICATION

I hereby certify that this report for the final drainage design of the High Prairie Farms Maintenance Facility was prepared by me (or under my direct supervision) in accordance with the provisions of Douglas County Drainage Design and Technical Criteria for the owners thereof. I understand that Douglas County does not and will not assume liability for drainage facilities designed by others.

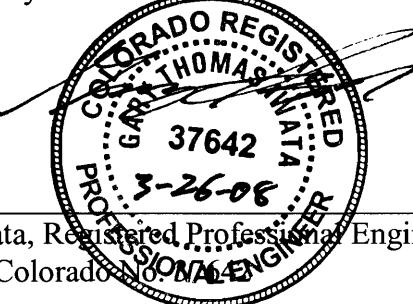

Gary Iwata, Registered Professional Engineer
State of Colorado No. 37642

The High Prairie Metro District hereby certifies that the drainage facilities for the High Prairie Farms Maintenance Facility shall be constructed according to the design presented in this report. I understand that Douglas County does not and will not assume liability for the drainage facilities designed and/or certified by my engineer and that Douglas County reviews drainage plans pursuant to Colorado Revised Statutes, Title 30, Article 28; but cannot, on behalf of the High Prairie Farms Maintenance Facility, guarantee that final drainage design review will absolve High Prairie Metro District and/or their successors and/or assigns of future liability for improper design. I further understand that approval of the Final Plat does not imply approval of my engineer's drainage design.



Kenneth Black
High Prairie Metro District
c/o Clifton Gunderson

TABLE OF CONTENTS

	<u>PAGE</u>
Certifications.....	i
Vicinity Map	ii
Table of Contents.....	iii
 I. GENERAL LOCATION AND DESCRIPTION	1
A. Location.....	1
B. Description of Property	1
 II. DRAINAGE BASINS AND SUB-BASINS.....	1
A. Major Basin Description	1
B. Sub-Basin Description (Historic)	1
C. Sub-Basin Description (Developed).....	1
 III. DRAINAGE DESIGN CRITERIA.....	2
A. Regulations.....	2
B. Development Criteria Reference and Constraints	2
C. Hydrologic Criteria.....	2
D. Hydraulic Criteria.....	2
 IV. DRAINAGE FACILITY DESIGN	2
A. General Concept.....	2
 V. CONCLUSION/ SUMMARY	3
 VI. REFERENCES	3
 APPENDIX A	
FIRM, Douglas County Panel 204
SCS Soil Map.....
 APPENDIX B	
Developed & Historic Composite Basin Weighted “%” Impervious Calculations
Developed & Historic Composite Basin Weighted “C” Calculations
Developed & Historic Composite Basin Weighted “Slope” Calculations.....
Developed & Historic Rational Method Calculations
Figure 6-1: Rainfall Zones
Figure 6-2: Time-Intensity Frequency Curves
Table RO-3: Recommended Percentage Imperviousness Values
Figure RO-4: Watershed Imperviousness, Single Family Residential House

APPENDIX C


StormCAD Schematic.....
StormCAD Reports.....
StormCAD Profiles.....

APPENDIX D

Detention Pond Calculations.....

APPENDIX E

Historic Drainage Maps
Proposed Drainage Maps

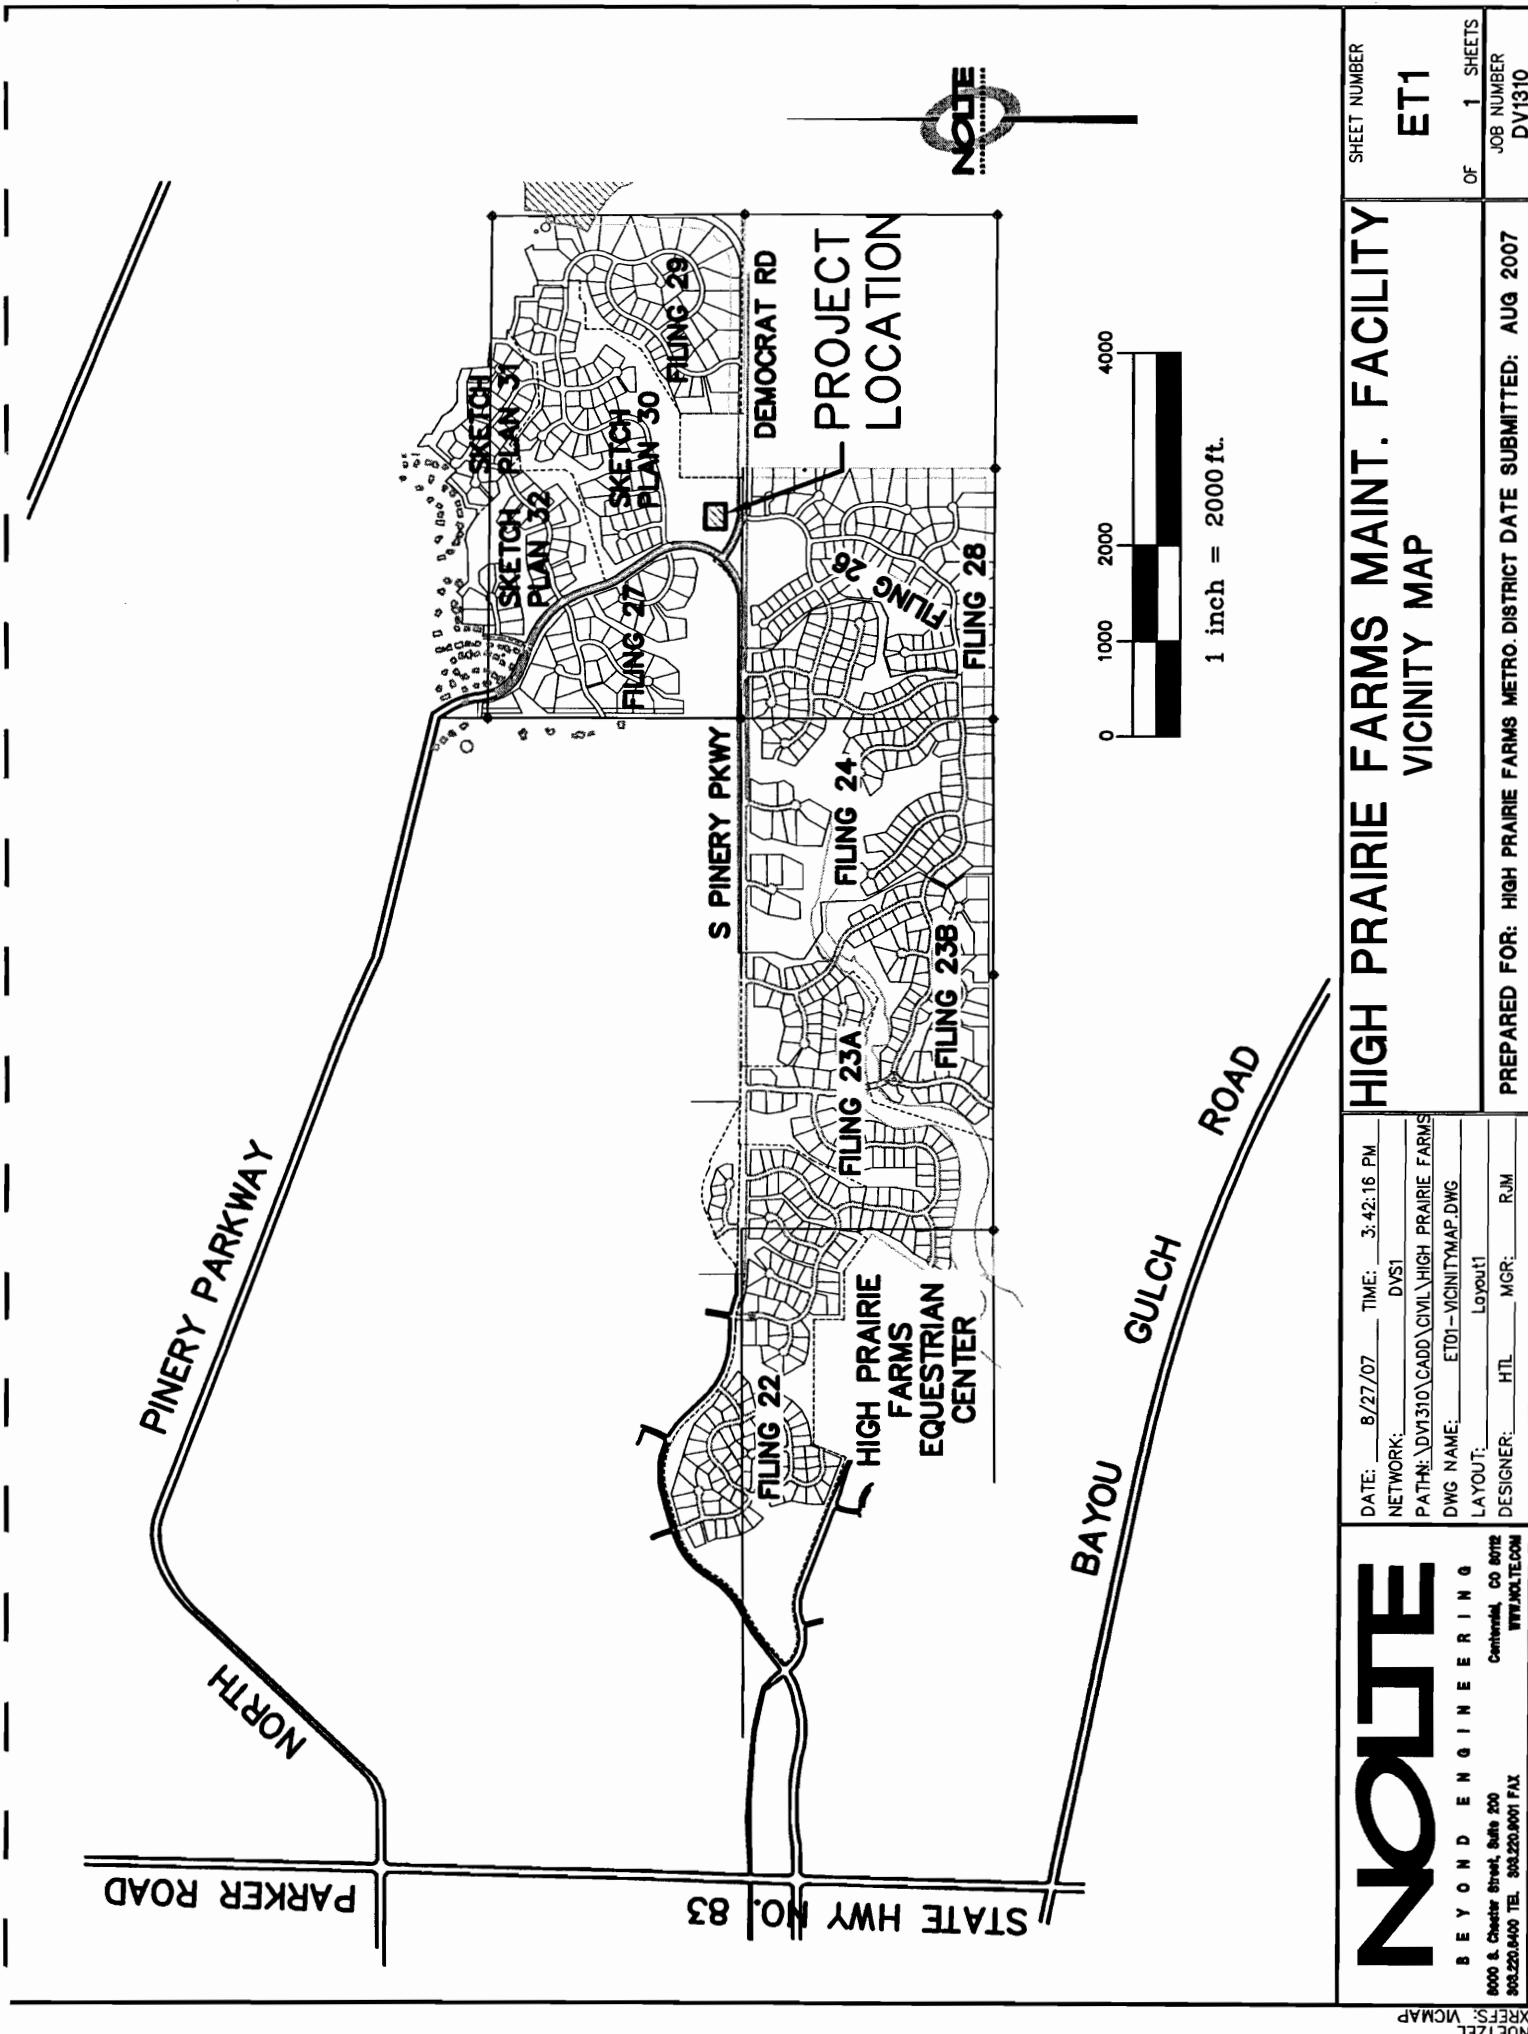

NETZEL MCMAPIREFS

1 GENERAL LOCATION AND DESCRIPTION**A. Location**

The proposed High Prairie Farms Maintenance Facility is located in the **northeast quarter of Section 18**, Township 7 South, Range 65 West of the Sixth Principal Meridian, Douglas County, Colorado. The project will be located on existing Democrat Road, at the northeast corner of the intersection with North Pinery Parkway. (See vicinity map).

B. Description of Property

The proposed High Prairie Farms Maintenance Facility is a 2,500 square foot building on a 0.13 acre lot. The existing vegetation consists of numerous pine trees, native grasses and brush. Onsite soils are in the Stapleton-Bresser Association, with slopes ranging from two to thirty percent.

The existing site drains to the north into an existing drainage way. The existing drainage way drains to the west into an existing culvert underneath North Pinery Parkway and is conveyed in Timbers Creek until it reaches Bayou Gulch. Bayou Gulch ultimately drains into Cherry Creek.

2 DRAINAGE BASINS AND SUB-BASINS**A. Major Basin Description**

Historically, the site drains to the north. The proposed development will not change the historic flow patterns. A detention pond will be constructed on the back of the building (north side), that will capture all the developed flow from the building and release it at historic rates.

The property is not located in a FEMA dedicated floodplain REF Flood Insurance Rate Map Douglas County Colorado Panels 204 number 080049 suffix F.

B. Sub-basin Description (Historic)

Basin H1 is an offsite basin that drains to the north into the existing drainage way. This basin contains brush, native grasses, and select areas of pine trees.

C. Sub-basin Description (Developed)

Basin A1 is the main basin created by this project. It includes the proposed building, driveway and detention pond. Flows will be collected in the swales on either side of the building and then run north to a pair of forebays and into the detention pond.

Basin B1 is on the north side of the detention pond. It includes the slope down from the proposed detention pond to the existing grade. This area will be replanted with

native vegetation and not permanently irrigated. This area is expected to generate flows similar to the existing conditions and will not be captured in the detention pond.

3 DRAINAGE DESIGN CRITERIA

A. Regulations

The Phase III Drainage Report for High Prairie Farms Maintenance Facility complies with procedures outlined in the *Douglas County Storm Drainage Design and Technical Criteria* and the *Urban Storm Drainage Criteria Manual*. The High Prairie Farms Maintenance Facility is within the Pinery Development, which is a part of the Timbers Creek Basin.

B. Development Criteria References and Constraints

The Phase III Drainage Report for High Prairie Farms Maintenance Facility complies with proposed Pinery Regional Drainage Study.

C. Hydrologic Criteria

The one-hour design point rainfall values for the High Prairie Farms Maintenance Facility development are:

10-yr recurrence interval storm = 1.66 in/hr

100-yr recurrence interval storm = 2.60 in/hr

The proposed development falls within Zone 1, so the appropriate *Time Intensity Frequency Curve Formulas* from the *Douglas County Storm Drainage Design and Technical Criteria* were used (see Appendix A). Runoff calculations were done utilizing the Rational Method for all storm events. Hydrologic calculations can be found in Appendix A. Runoff coefficients used were based on composite impervious values defined in the *Urban Storm Drainage Criteria Manual* (see Appendix A). Composite percent imperviousness was determined by way of the land uses on each basin and the related percent imperviousness found in the *Urban Storm Drainage Criteria Manual*. The resultant percent imperviousness was applied to equations from the *Urban Storm Drainage Criteria Manual*.

D. Hydraulic Criteria

A channel rundown was designed utilizing FlowMaster by *Haestad Methods*, which conforms to normal open channel calculation procedures with Manning's formula. Storm pipe capacities and Hydraulic Grade Lines were determined using StormCad by *Haestad Methods*, which utilizes common calculating procedures outlined in the *Criteria*. Hydraulic calculations can be found in Appendix B.

4 DRAINAGE FACILITY DESIGN

A. General Concept

The general drainage concept for High Prairie Farms Maintenance Facility is to capture the runoff from the building in the pond behind the building.

Water quality enhancement measures will be incorporated into the detention pond. The Excess Urban Runoff Volume (EURV) for the detention pond is calculated based on the Excess Urban Runoff Volume design in *the Urban Storm Drainage Criteria Manual, Volume 2 – Storage*. The development of the High Prairie Farms Maintenance Facility will detain drainage and release it at allowable rate into the channel to the north. The detention pond will provide several features to help with water quality. First, the forebay will allow for larger particles to settle out into the bottom and still allow water to pass at a controlled rate into the rest of the pond. The release structure has two different releases. The first is the Excess Urban Runoff Volume (EURV). There will be a plate attached to the front of the outlet structure to allow this EURV to be released over a 72-hour period. In addition, there will be a trash rack in front of the EURV plate to help prevent clogging, but will not interfere with the hydraulic capacity of the outlet. The top of the plate will have a notch to release the 100-year event not exceed the historic rate for the major storm.

5 CONCLUSIONS / SUMMARY

All drainage calculations and drainage solutions were done in compliance with *Douglas County Storm Drainage Design and Technical Criteria*, the drainage studies for surrounding developments and the *Urban Storm Drainage Criteria Manual*. The storm sewers will release into channels or to the detention ponds. The proposed detention pond has been designed to meet current standards set fourth by the *Criteria* and do not exceed calculated historic flow rates. The drainage system has been designed to control discharge of storm water and safely convey it from the site in compliance with local regulations.

6 REFERENCES

- A. *Douglas County Storm Drainage Design and Technical Criteria*, January 1986.
- B. *Urban Storm Drainage Criteria Manual, Volume 1*, June 2001, Urban Storm Drainage and Flood Control District.
- C. *Urban Storm Drainage Criteria Manual, Volume 2*, June 2001, Urban Storm Drainage and Flood Control District.
- D. *Urban Storm Drainage Criteria Manual, Volume 3*, September 1999, Urban Storm Drainage and Flood Control District.

APPENDIX A
MAPS
(FIRM, SCS)



MAP SCALE 1" = 500'
250 0 500 1000 FEET

PANEL 0204F

FIRM
FLOOD INSURANCE RATE MAP
DOUGLAS COUNTY,
COLORADO
AND INCORPORATED AREAS

PANEL 204 OF 495

(SEE MAP INDEX FOR FIRM PANEL LAYOUT)

CONTAINS	COMMUNITY	NUMBER	PANEL	SUFFIX
	DOUGLAS COUNTY	080349	0204	F

Notice to User: The Map Number shown below should be used when placing map orders; the Community Number shown above should be used on insurance applications for the subject community.

MAP NUMBER
080349C0204F

EFFECTIVE DATE:
SEPTEMBER 30, 2005



Federal Emergency Management Agency

This is an official copy of a portion of the above referenced flood map. It was extracted using F-MIT On-Line. This map does not reflect changes or amendments which may have been made subsequent to the date on the title block. For the latest product information about National Flood Insurance Program flood maps, check the FEMA Flood Map Store at www.msic.fema.gov

NOTE

DEMOCRAT RD

18

PINERY PKWY

13

ENTIRE PROJECT
WITHIN ZONE X

PROJECT
SITE


ZONE A
LIMIT OF
STUDY
CULVERT
CULVERT
DAM
ZONE X

PINERY
PKWY

90000 FT

JOINS PANEL 0203

PREPARED FOR: HIGH PRAIRIE FARMS METRO DISTRICT DATE SUBMITTED: AUG 2007
 HIGH PRAIRIE FARMS MAINT. FACILITY SCS SOILS MAP
 NOLE

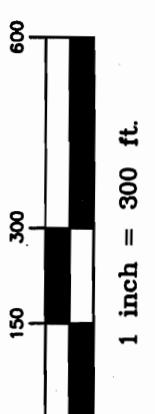

SYMBOL	HYDROLOGIC SOILS GROUP	NAME
St	B	STAPLETON-BRESSER ASSOCIATION
BrD	B	BRESSER SANDY LOAM
NsE	B	NEWLIN-SATANTA COMPLEX
SsE	B	STAPLETON LOAMY SAND
PrE2	B	PEYTON-PRING-CROWFOOT COMPLEX

APPENDIX B

HYDROLOGY CALCULATIONS

DEVELOPED COMPOSITE % IMPERVIOUS

DEVELOPED COMPOSITE WEIGHTED “C”

DEVELOPED COMPOSITE SLOPE

DEVELOPED RATIONAL METHOD CALCULATIONS

RELATED CHARTS, FIGURES & GRAPHS

DEVELOPED COMPOSITE BASIN -WEIGHTED "% IMPERVIOUS" CALCULATIONS
-REFERENCE TABLE RO-3 DRAINAGE CRITERIA MANUAL (1.1)

COMPOSITE DEVELOPED BASIN -WEIGHTED "C" CALCULATIONS (10-YEAR & 100-YEAR)

$$C_A = K_A + (1.31i^3 - 1.44i^2 + 1.135i - 0.12) \text{ for } C_A > 0, \text{ otherwise } C_A = 0 \quad (\text{RO-6})$$

$$C_B = (C_A + C_{CD})/2 \quad (\text{RO-7})$$

$$C_{CD} = K_{CD} + (0.858i^3 - 0.786i^2 + 0.774i + 0.04)$$

i = % imperviousness/100 expressed as a decimal

K_A = Correction factor for Type A soils

K_{CD} = Correction factor for Type C and Type D soils

		Correction Factors, K_A & K_{CD}					
		Storm Return Period					
		2-Year		5-Year		10-Year	
Soil Type		A	0	-0.081 + 0.09	-0.141 + 0.17	-0.251 + 0.32	
	C or D	0	0	-0.101 + 0.11	-0.181 + 0.21	-0.391 + 0.46	

Basin ID	% Imperv.	i	Soil Type	Correction Factors, K_A & K_{CD}			Basin Area	Total Area	Weighted Runoff Coefficients, C
				2-Year	5-Year	10-Year			
A1	41.04%	0.41	A	0.00	0.06	0.11	0.22	0.19	0.25
			B	-	-	-	0.24	0.30	0.36
			C or D	0.00	0.07	0.14	0.30	0.28	0.35
B1	2.00%	0.02	A	0.00	0.09	0.17	0.32	0.00	0.07
			B	-	-	-	0.03	0.08	0.17
			C or D	0.00	0.11	0.21	0.45	0.06	0.16

COMPOSITE HISTORIC BASIN -WEIGHTED "C" CALCULATIONS (10-YEAR & 100-YEAR)

H1	2.00%	0.02	A	Runoff Coefficients, C			Basin Area	Total Area	Weighted Runoff Coefficients, C
				2-Year	5-Year	10-Year			
			B	-	-	-			
			C or D	0.00	0.11	0.21	0.45	0.06	0.16
							0.26	0.51	0.36

High Prairie Farms Maintenance Facility
Phase III Drainage Report

8/24/2007
TAN

High Prairie Farms Maintenance Facility

Historic Runoff Calculations

<i>Time of Concentration</i>		Forest & Meadow			Short Grass Pasture & Lawns			Watercourse Coefficient			Grassed Waterway		
		Tillage/ Field			Nearly Bare Ground			10.00			Paved Area & Shallow Gutter		
		INITIAL / OVERLAND			TRAVEL TIME			7.00			20.00		
SUB-BASIN DATA		T(i)	Length	Slope	T(i)	Length	Slope	Coeff.	Velocity	T(i)	T(c)	FINAL T(c)	
DESIGN POINT	DRAIN BASIN	C(5) ac.	ft.	%	min	ft.	%	%	fps	min.	COMP. T(c)	(URBANIZED BASINS) L/180+10 min.	
H1	H1	0.47	0.08	130	2.0%	16.9	95	13.00	7.00	25.2	0.1	17.0 225 11.3 11.3	

High Prairie Farms Maintenance Facility

Historic Runoff Calculations

<i>Time of Concentration</i>		Forest & Meadow			Short Grass Pasture & Lawns			Watercourse Coefficient			Grassed Waterway		
		Tillage/ Field			Nearly Bare Ground			10.00			Paved Area & Shallow Gutter		
		INITIAL / OVERLAND			TRAVEL TIME			7.00			20.00		
SUB-BASIN DATA		T(i)	Length	Slope	T(i)	Length	Slope	Coeff.	Velocity	T(i)	T(c)	FINAL T(c)	
DESIGN POINT	DRAIN BASIN	C(5) ac.	ft.	%	min	ft.	%	%	fps	min.	COMP. T(c)	(URBANIZED BASINS) L/180+10 min.	
H1	H1	0.47	0.08	130	2.0%	16.9	95	13.00	7.00	25.2	0.1	17.0 225 11.3 11.3	

High Prairie Farms Maintenance Facility
Phase III Drainage Report

High Prairie Farms Maintenance Facility
Historic Runoff Calculations

(Rational Method Procedure)

Design Storm 5 Year Historic

BASIN INFORMATION			DIRECT RUNOFF			TOTAL RUNOFF			REMARKS	
DESIGN POINT	DRAIN BASIN	AREA ac.	RUNOFF COEFF	T(C) min	C x A	1 in/hr	Q cfs	T(C) min	SUM C x A in/hr	Q cfs
H1	H1	0.47	0.08	11.3	0.04	3.69	0.1			

High Prairie Farms Maintenance Facility
Phase III Drainage Report

High Prairie Farms Maintenance Facility
Historic Runoff Calculations

(Rational Method Procedure)

Design Storm 10 Year Historic

BASIN INFORMATION			DIRECT RUNOFF				TOTAL RUNOFF				
DESIGN POINT	DRAIN BASIN	AREA ac.	RUNOFF COEFF	T(c) min	C x A	I in/hr	Q cfs	T(c) min	C x A	Q cfs	REMARKS
H1	H1	0.47	0.17	11.3	0.08	6.74	0.5				

High Prairie Farms Maintenance Facility
Phase III Drainage Report

8/24/2007
TAN

High Prairie Farms Maintenance Facility
Historic Runoff Calculations

(Rational Method Procedure)

Design Storm 100 Year Historic

BASIN INFORMATION			DIRECT RUNOFF				TOTAL RUNOFF				
DESIGN POINT	DRAIN BASIN	AREA ac.	RUNOFF COEFF	T(c) min	C x A	I in/hr	Q cfs	T(c) min	C x A	I in/hr	Q cfs
H1	H1	0.47	0.36	11.3	0.17	6.74	1.14				

High Prairie Farms Maintenance Facility
Phase III Drainage Report

8/24/2007
 TAN

High Prairie Farms Maintenance Facility
Developed Runoff Calculations
Time of Concentration

Watercourse Coefficient

Forest & Meadow 2.50
 Short Grass Pasture & Lawns 7.00

Tillage/ Field 5.00
 Nearly Bare Ground 10.00

Grassed Waterway 15.00
 Paved Area & Shallow Gutter 20.00

SUB-BASIN DATA			INITIAL / OVERLAND TIME			TRAVEL TIME			FINAL CHECK (URBANIZED BASINS)		
DESIGN POINT	DRAIN BASIN	C(5) ac.	Length ft.	Slope %	T(i) min	Length ft.	Slope %	Coeff.	Velocity f/s	T(t) min.	T(c) min.
A1	A1	0.34	0.30	40	2.0%	7.3	80	2.00	7.00	9.9	0.1
B1	B1	0.13	0.08	50	25.0%	4.5	0	2.00	0.00	0.0	5.0

High Prairie Farms Maintenance Facility
Phase III Drainage Report

High Prairie Farms Maintenance Facility
Developed Runoff Calculations
(Rational Method Procedure)

Design Storm 5 Year Developed

BASIN INFORMATION			DIRECT RUNOFF			TOTAL RUNOFF				
DESIGN POINT	DRAIN BASIN	AREA ac.	RUNOFF COEFF	T(c) min	C x A in/hr	Q cfs	T(c) min	C x A in/hr	Q cfs	REMARKS
A1	A1	0.34	0.30	7.4	0.10	4.40	0.45			
B1	B1	0.13	0.08	5.0	0.01	4.92	0.05			

High Prairie Farms Maintenance Facility
Phase III Drainage Report

High Prairie Farms Maintenance Facility
Developed Runoff Calculations
(Rational Method Procedure)

Design Storm 10 Year Developed

BASIN INFORMATION			DIRECT RUNOFF			TOTAL RUNOFF			REMARKS	
DESIGN POINT	DRAIN BASIN	AREA ac.	RUNOFF COEFF	T(c) min	Q cfs	T(c) min	SUM C x A	I in/hr	Q cfs	
A1	A1	0.34	0.36	7.4	0.12	5.16	0.63			
B1	B1	0.13	0.17	5.0	0.02	5.76	0.13			

High Prairie Farms Maintenance Facility
Phase III Drainage Report

High Prairie Farms Maintenance Facility
Developed Runoff Calculations

(Rational Method Procedure)

Design Storm 100 Year Developed

BASIN INFORMATION				DIRECT RUNOFF				TOTAL RUNOFF			
DESIGN POINT	DRAIN BASIN	AREA ac.	RUNOFF COEFF	T(c) min	C x A	I in/hr	Q cfs	T(c) min	C x A	SUM in/hr	Q cfs
A1	A1	0.34	0.50	7.4	0.17	8.08	1.35				
B1	B1	0.13	0.36	5.0	0.05	9.05	0.43				

FIGURE 6-1
DOUGLAS COUNTY RAINFALL ZONES

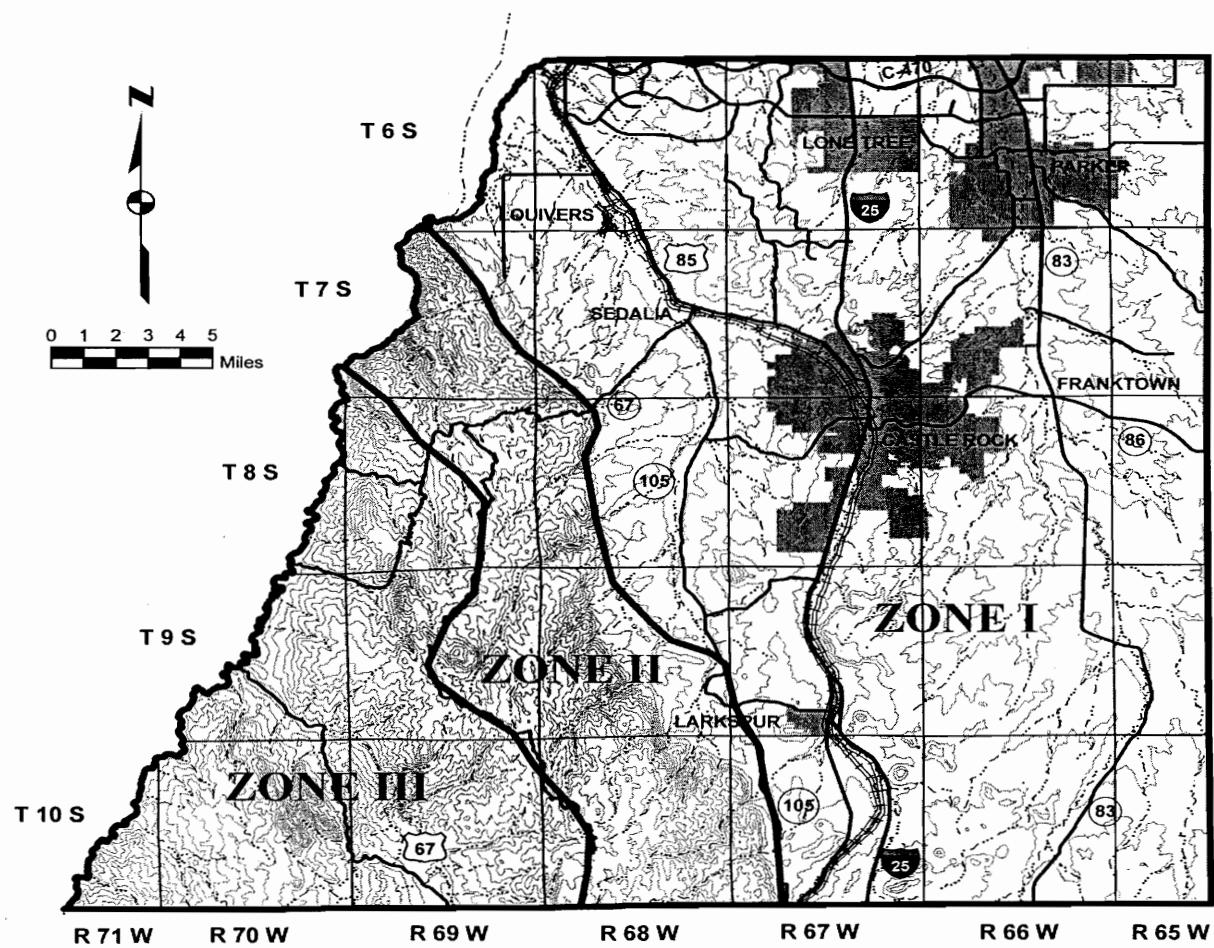


FIGURE 6-2
RAINFALL INTENSITY-DURATION CURVE
DOUGLAS COUNTY ZONE I

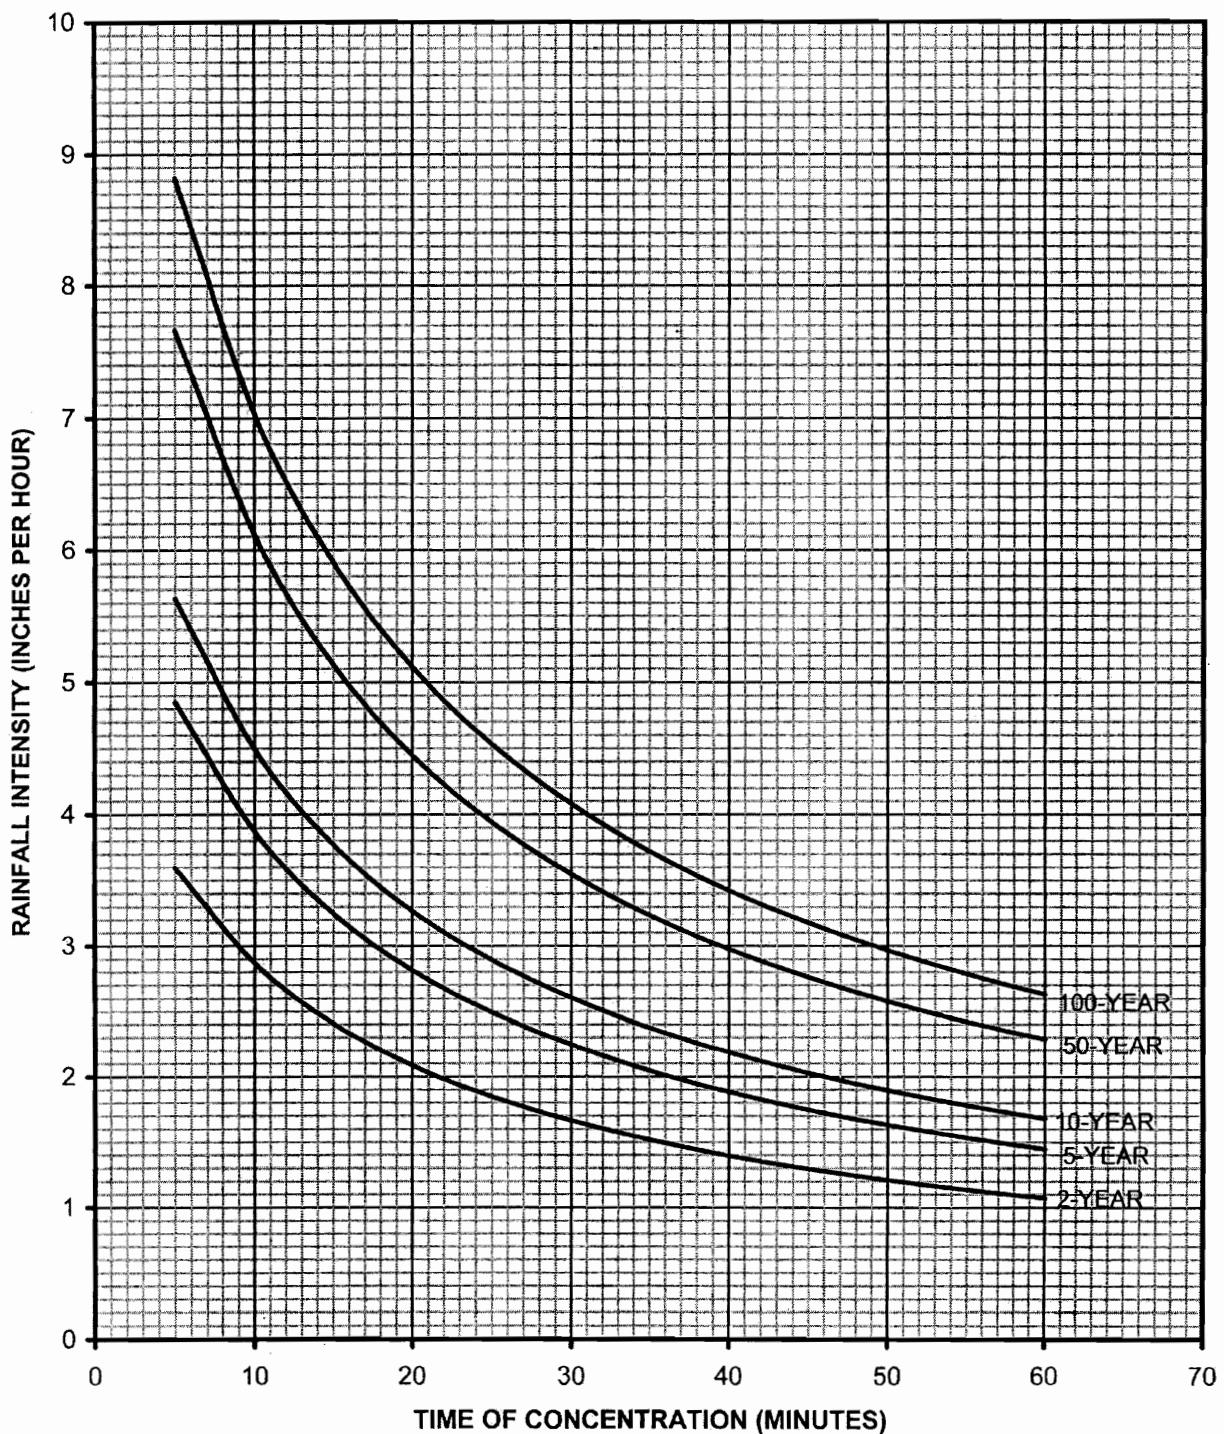


Table RO-3—Recommended Percentage Imperviousness Values

Land Use or Surface Characteristics	Percentage Imperviousness
Business:	
Commercial areas	95
Neighborhood areas	85
Residential:	
Single-family	*
Multi-unit (detached)	60
Multi-unit (attached)	75
Half-acre lot or larger	*
Apartments	80
Industrial:	
Light areas	80
Heavy areas	90
Parks, cemeteries	5
Playgrounds	10
Schools	50
Railroad yard areas	15
Undeveloped Areas:	
Historic flow analysis	2
Greenbelts, agricultural	2
Off-site flow analysis (when land use not defined)	45
Streets:	
Paved	100
Gravel (packed)	40
Drive and walks	90
Roofs	90
Lawns, sandy soil	0
Lawns, clayey soil	0

* See Figures RO-3 through RO-5 for percentage imperviousness.

$$C_A = K_A + (1.31i^3 - 1.44i^2 + 1.135i - 0.12) \text{ for } C_A \geq 0, \text{ otherwise } C_A = 0 \quad (\text{RO-6})$$

$$C_{CD} = K_{CD} + (0.858i^3 - 0.786i^2 + 0.774i + 0.04) \quad (\text{RO-7})$$

$$C_B = (C_A + C_{CD})/2$$

in which:

i = % imperviousness/100 expressed as a decimal (see Table RO-3)

C_A = Runoff coefficient for Natural Resources Conservation Service (NRCS) Type A soils

C_B = Runoff coefficient for NRCS Type B soils

C_{CD} = Runoff coefficient for NRCS Type C and D soils

K_A = Correction factor for Type A soils defined in Table RO-4

K_{CD} = Correction factor for Type C and D soils defined in Table RO-4

Table RO-4—Correction Factors K_A and K_{CD} for Use with Equations RO-6 and RO-7

NRCS Soil Type	Storm Return Period					
	2-Year	5-Year	10-Year	25-Year	50-Year	100-Year
C and D	0	$-0.10i + 0.11$	$-0.18i + 0.21$	$-0.28i + 0.33$	$-0.33i + 0.40$	$-0.39i + 0.46$
A	0	$-0.08i + 0.09$	$-0.14i + 0.17$	$-0.19i + 0.24$	$-0.22i + 0.28$	$-0.25i + 0.32$

The values for various catchment imperviousnesses and storm return periods are presented graphically in Figures RO-6 through RO-8, and are tabulated in Table RO-5. These coefficients were developed for the Denver region to work in conjunction with the time of concentration recommendations in Section 2.4. Use of these coefficients and this procedure outside of the semi-arid climate found in the Denver region may not be valid. The *UD-Rational* spreadsheet performs all the needed calculations to find the runoff coefficient given the soil type and imperviousness and the reader may want to take advantage of this macro-enabled Excel workbook that is available for download from the District's web site www.udfcd.org under "Download" – "Technical Downloads."

See Examples 7.1 and 7.2 that illustrate the Rational method. The use of the Rational method in storm sewer design is illustrated in Example 6.13 of the STREETS/INLETS/STORM SEWERS chapter.

Table RO-5—Runoff Coefficients, C

Percentage Imperviousness	Type C and D NRCS Hydrologic Soil Groups					
	2-yr	5-yr	10-yr	25-yr	50-yr	100-yr
0%	0.04	0.15	0.25	0.37	0.44	0.50
5%	0.08	0.18	0.28	0.39	0.46	0.52
10%	0.11	0.21	0.30	0.41	0.47	0.53
15%	0.14	0.24	0.32	0.43	0.49	0.54
20%	0.17	0.26	0.34	0.44	0.50	0.55
25%	0.20	0.28	0.36	0.46	0.51	0.56
30%	0.22	0.30	0.38	0.47	0.52	0.57
35%	0.25	0.33	0.40	0.48	0.53	0.57
40%	0.28	0.35	0.42	0.50	0.54	0.58
45%	0.31	0.37	0.44	0.51	0.55	0.59
50%	0.34	0.40	0.46	0.53	0.57	0.60
55%	0.37	0.43	0.48	0.55	0.58	0.62
60%	0.41	0.46	0.51	0.57	0.60	0.63
65%	0.45	0.49	0.54	0.59	0.62	0.65
70%	0.49	0.53	0.57	0.62	0.65	0.68
75%	0.54	0.58	0.62	0.66	0.68	0.71
80%	0.60	0.63	0.66	0.70	0.72	0.74
85%	0.66	0.68	0.71	0.75	0.77	0.79
90%	0.73	0.75	0.77	0.80	0.82	0.83
95%	0.80	0.82	0.84	0.87	0.88	0.89
100%	0.89	0.90	0.92	0.94	0.95	0.96
TYPE B NRCS HYDROLOGIC SOILS GROUP						
0%	0.02	0.08	0.15	0.25	0.30	0.35
5%	0.04	0.10	0.19	0.28	0.33	0.38
10%	0.06	0.14	0.22	0.31	0.36	0.40
15%	0.08	0.17	0.25	0.33	0.38	0.42
20%	0.12	0.20	0.27	0.35	0.40	0.44
25%	0.15	0.22	0.30	0.37	0.41	0.46
30%	0.18	0.25	0.32	0.39	0.43	0.47
35%	0.20	0.27	0.34	0.41	0.44	0.48
40%	0.23	0.30	0.36	0.42	0.46	0.50
45%	0.26	0.32	0.38	0.44	0.48	0.51
50%	0.29	0.35	0.40	0.46	0.49	0.52
55%	0.33	0.38	0.43	0.48	0.51	0.54
60%	0.37	0.41	0.46	0.51	0.54	0.56
65%	0.41	0.45	0.49	0.54	0.57	0.59
70%	0.45	0.49	0.53	0.58	0.60	0.62
75%	0.51	0.54	0.58	0.62	0.64	0.66
80%	0.57	0.59	0.63	0.66	0.68	0.70
85%	0.63	0.66	0.69	0.72	0.73	0.75
90%	0.71	0.73	0.75	0.78	0.80	0.81
95%	0.79	0.81	0.83	0.85	0.87	0.88
100%	0.89	0.90	0.92	0.94	0.95	0.96


APPENDIX C

HYDRAULIC CALCULATIONS

STORMCAD ANALYSIS

Scenario: 100yr

HEADWALL

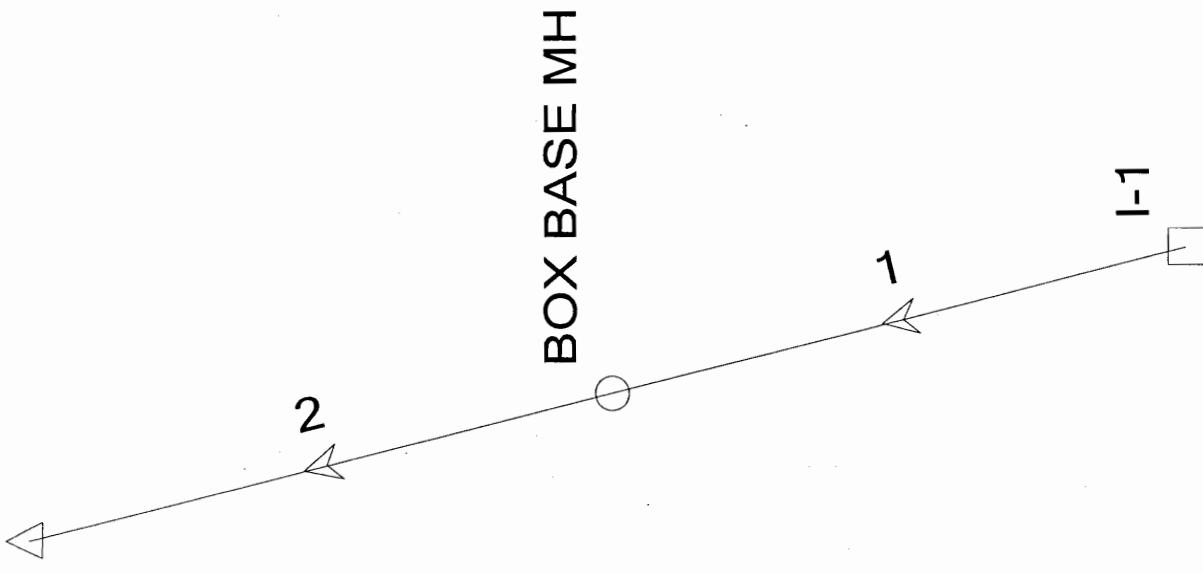

Scenario: EURV

Combined Pipe\Node Report

Label	Upstream Node	Downstream Node	Length (ft)	Section Size	Total System Flow (cfs)	Full Capacity (cfs)	Flow / Full Capacity (%)	Average Velocity (ft/s)	Upstream Invert Elevation (ft)	Downstream Invert Elevation (ft)	Constructed Slope (%)	Hydraulic Grade Line In (ft)	Hydraulic Grade Line Out (ft)
1	I-1	BOX BASE N	47.16	18 inch	0.02	33.23	0.06	2.55	6,373.00	6,368.28	10.01	6,373.05	6,368.31
2	BOX BASE M	HEADWALL	47.00	18 inch	0.02	16.92	0.12	1.59	6,364.28	6,363.06	2.60	6,364.33	6,363.20


Scenario: 100yr

Combined Pipe\Node Report

Label	Upstream Node	Downstream Node	Length (ft)	Section Size	Total System Flow (cfs)	Full Capacity (cfs)	Flow / Full Capacity (%)	Average Velocity (ft/s)	Upstream Invert Elevation (ft)	Downstream Invert Elevation (ft)	Constructed Slope (%)	Hydraulic Grade Line In (ft)	Hydraulic Grade Line Out (ft)
1	I-1	BOX BASE M	47.16	18 inch	0.34	33.23	1.02	6.08	6,373.00	6,368.28	10.01	6,373.22	6,368.39
2	BOX BASE M HEADWALL		47.00	18 inch	0.34	16.92	2.01	3.80	6,364.28	6,363.06	2.60	6,364.50	6,363.21

Profile Scenario: 100yr

Profile: Pond Outlet
Scenario: 100yr

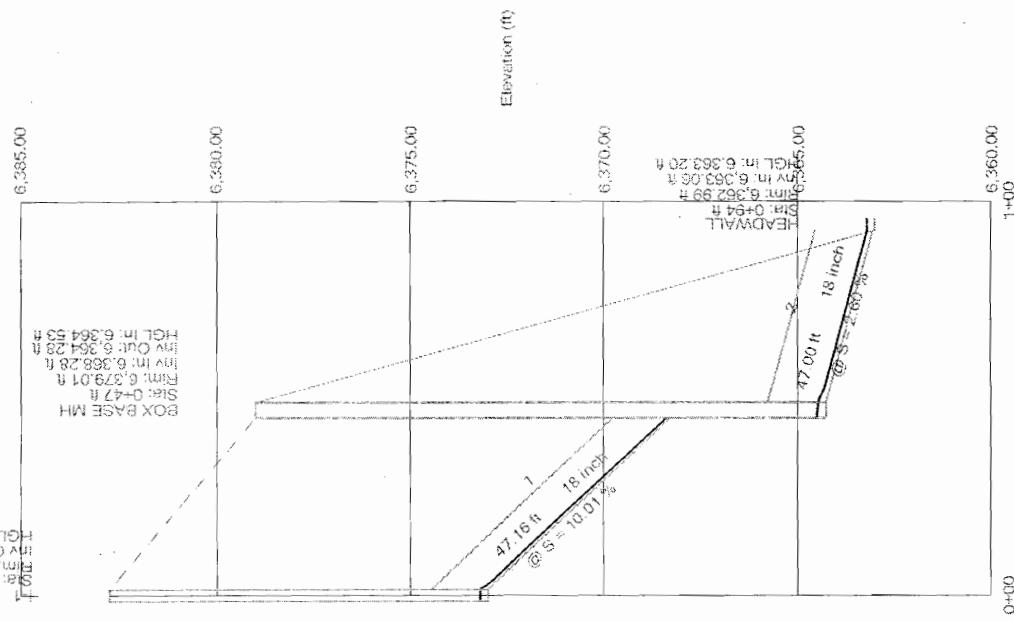

APPENDIX D

DETENTION AND WATER QUALITY

EXCESS URBAN RUNOFF CONTROL (FULL-SPECTRUM) DETENTION SIZING

Project: High Prairie Farms Maintenance Facility


Basin ID:

* User input data shown in blue.

Area of Watershed (acres)	0.336	
Subwatershed Imperviousness	100.0%	
Level of Minimizing Directly Connected Impervious Area (MDCIA)	0	0 <input type="button" value="▼"/>
Effective Imperviousness ¹		100.0%
Hydrologic Soil Type	Percentage of Area	Area (acres)
Type A		0.0
Type B		0.0
Type C or D	100.0%	0.3

Recommended Horton's Equation Parameters for CUHP		
Infiltration (inches per hour)	Initial-- f_i	Final-- f_o
	3	0.5
		0.0018

Detention Volumes ^{2,5}		Maximum Allowable Release Rate, cfs ³
(watershed inches)	(acre-feet)	
1.21	0.0340	Design Outlet to Empty EURV in 72 Hours
2.61	0.0731	0.34

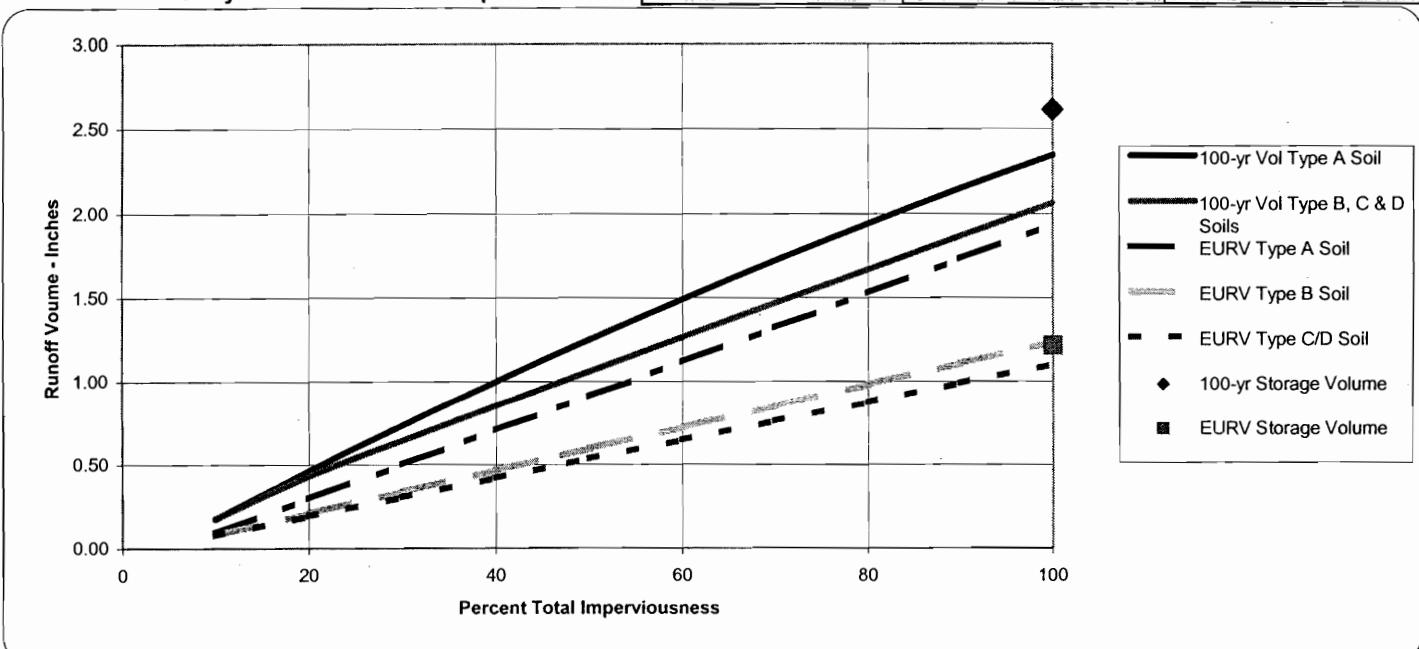

Notes:

- 1) Effective imperviousness is based on Figure ND-1 of the Urban Storm Drainage Criteria Manual (USDCM).
- 2) Results shown reflect runoff reduction from Level 1 or 2 MDCIA and are plotted at the watershed's total imperviousness value; the impact of MDCIA is reflected by the results being below the curves.
- 3) Maximum allowable release rates for 100-year event are based on Table SO-1. Outlet for the Excess Urban Runoff Volume (EURV) to be designed to empty out the EURV in 72 hours. Outlet design is similar to one for the WQCV outlet of an extended detention basin (i.e., perforated plate with a micro-pool) and extends to top of EURV water surface elevation.
- 4) EURV approximates the difference between developed and pre-developed runoff volume.
- 5) User has opted to add the WQCV to the 100-year detention volume to satisfy local regulations. This is not required per the USDCM.

EMPIRICAL 10-YEAR AND 100-YEAR DETENTION VOLUME CALCULATIONS
-REFERENCE UDFCD DRAINAGE CRITERIA MANUAL (V.2)

$$V_{10,100} = KA$$

$$K_{10} = (0.95I - 1.90) / 1000 \quad (\text{EQUATION SO-2})$$

$$K_{100} = (1.78I - 0.002I^2 - 3.56) / 900 \quad (\text{EQUATION SO-3})$$

A = Tributary Area (acres)

I = Imperviousness of Tributary Area (%)

$$A = 0.336$$

$$I = 100.00$$

Required V_{10} (Ac-ft) = 0.031

Required V_{100} (Ac-ft) = 0.058

WATER QUALITY CAPTURE VOLUME CALCULATIONS

-REFERENCE UDFCD DRAINAGE CRITERIA MANUAL VOL. 3 FIGURE EDB-2

Water Quality Capture Volume = WQCV = $a * (0.91i^3 - 1.19i^2 + 0.78i)$ (watershed inches)

i = Total Imperviousness Ratio = $I_{WQ} / 100$

a = 40-hr Drain Time = 1.0

Required Storage = [WQCV/12]*A*1.2 (acre-ft)

A = Tributary Catchments Area (acres)

1.2 Factor = Multiplier to account for 20% sediment accumulation

$$i = 1.00$$

Required WQCV (watershed in) = 0.500

Required WQCV (Ac-ft) = 0.017

Forebay (3%) = 0.0005

Forebay (5%) = 0.0008

Micropool (0.5%) = 0.0001

DETENTION POND - STAGE/DISCHARGE

PRISMOIDAL METHOD				
POND VOLUME = 1/3(A1+A2+(A1*A2)^0.5)*D				
DETENTION POND	ELEV	AREA SQ FT	INCREM	CUMM.
			VOLUME CU FT	VOLUME CU FT
	6379.08	0	0	0
	6379.50	0	0	0
	6380.00	238	40	40
	6380.50	537	189	229
	6381.00	840	341	570
WQCV WSE	6381.16			0.017
	6381.50	1,207	509	1,079
EURV WSE	6381.78			0.034
	6382.00	1,634	708	1,786
	6382.50	2,125	937	2,724
100-yr WSE	6382.72			0.074
	6383.00	2,699	1,203	3,927

Worksheet for 100-Yr - Rectangular Orifice

Project Description

Solve For Opening Width

Input Data

Discharge	0.320	ft ³ /s
Headwater Elevation	6382.72	ft
Centroid Elevation	6382.13	ft
Tailwater Elevation	6373.00	ft
Discharge Coefficient	0.65	
Opening Height	0.69	ft

Results

Opening Width	0.12	ft
Headwater Height Above Centroid	0.60	ft
Tailwater Height Above Centroid	-9.13	ft
Flow Area	11.46	in ²
Velocity	4.02	ft/s

OUTLET DESIGN

TOP OF MICROPOOL ELEV.= 6379.50 ft

EURV = 0.034 ac-ft
 ELEVATION = 6381.78 ft
 H (EURV) = 2.28 ft

100 YEAR VOLUME = 0.074 ac-ft
 ELEVATION = 6382.72 ft
 100_{year} Release = 0.34 cfs

EXCESS URBAN RUNOFF VOLUME ORIFICE CALCULATIONS

REFERENCE UDFCD DRAINAGE CRITERIA MANUAL VOL. 2 EQUATION SO-13a

$b = 0.0166H^2 + 0.2055H + 0.1543$ $b = 0.710$
 $c = -0.0018H^2 - 0.0068H + 1.0015$ $c = 0.977$
 $A = [(EURV)/b]^{(1/c)}$ $A = 0.04 \text{ in}^2$
 $D = 0.24 \text{ in}$
 $D = 2/8 \text{ in}$

100-YR WEIR DESIGN

$Q = CA * (2gh)^{.5} \text{ cfs}$
 $c = 0.65$
 $g = 32.17 \text{ ft/s}^2$
 $A = 0.00034 \text{ ft}^2$

EURV ELEV.	Elev. =	h =	Q =	Q total =
	6381.78			
	6381.50	0.28	0.00094	0.01349
	6381.17	0.61	0.00139	0.01255
	6380.83	0.95	0.00173	0.01116
	6380.50	1.28	0.00201	0.00943
	6380.17	1.61	0.00226	0.00742
	6379.83	1.95	0.00248	0.00516
TOP OF MICROPOOL ELEV.	6379.50	2.28	0.00268	0.00268

$Q_{100 \text{ weir}} = Q_{100} - Q_{\text{total eurv}} = 0.32 \text{ cfs}$

$Q_{100 \text{ weir}} = cbh^{(3/2)}$
 $c = 3.33$
 $h = 0.93 \text{ ft}$
 $b = Q/(ch^{(3/2)}) = 0.11 \text{ ft}$
 $= 1.3 \text{ in}$

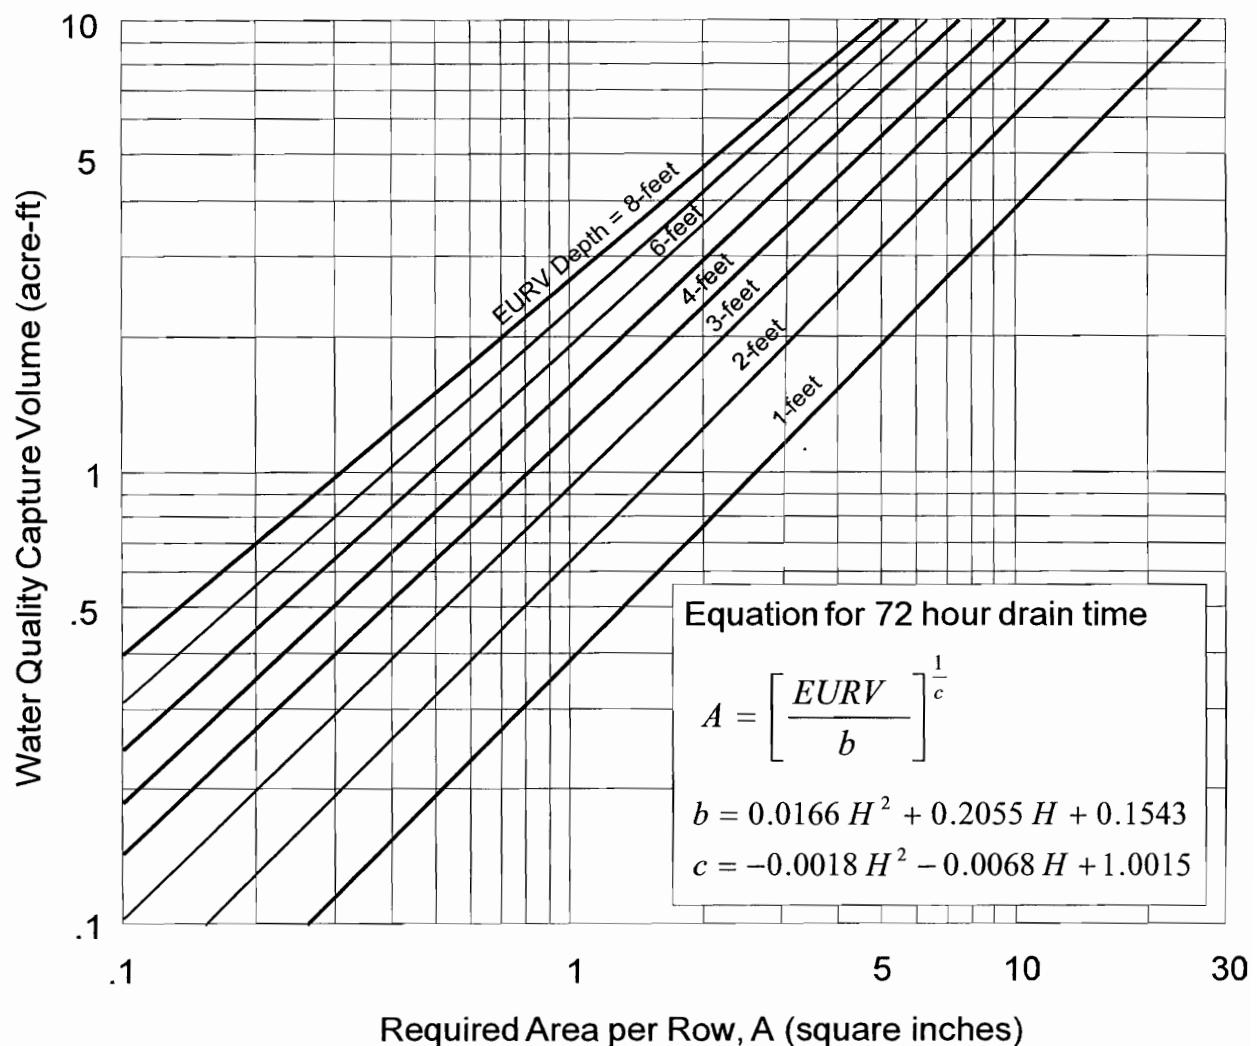


Figure SO-8—Outlet Sizing for EURV Control with 72-hour Drain Time for On-Site Detention

Orifice Plate Perforation Sizing

Circular Perforation Sizing

This table may be used to size perforation in a vertical plate of riser pipe.

Hole Dia. (in.) *	Hole Dia. (in.)	Min. S _c (in.)	Area per Row (sq. in.)		
			n = 1	n = 2	n = 3
1/4	0.250	1	0.05	0.10	0.15
5/16	0.313	2	0.08	0.16	0.24
3/8	0.375	2	0.11	0.22	0.33
7/16	0.438	2	0.15	0.30	0.45
1/2	0.500	2	0.20	0.40	0.60
9/16	0.563	3	0.25	0.50	0.75
5/8	0.625	3	0.31	0.62	0.93
11/16	0.688	3	0.37	0.74	1.11
3/4	0.750	3	0.44	0.88	1.32
13/16	0.813	3	0.52	1.04	1.56
7/8	0.875	3	0.60	1.20	1.80
15/16	0.938	3	0.69	1.38	2.07
1	1.000	4	0.79	1.58	2.37
1 1/16	1.063	4	0.89	1.78	2.67
1 1/8	1.125	4	0.99	1.98	2.97
1 3/16	1.188	4	1.11	2.22	3.33
1 1/4	1.250	4	1.23	2.46	3.69
1 5/16	1.313	4	1.35	2.70	4.05
1 3/8	1.375	4	1.48	2.96	4.44
1 7/16	1.438	4	1.62	3.24	4.86
1 1/2	1.500	4	1.77	3.54	5.31
1 9/16	1.563	4	1.92	3.84	5.76
1 5/8	1.625	4	2.07	4.14	6.21
1 11/16	1.688	4	2.24	4.48	6.72
1 3/4	1.750	4	2.41	4.82	7.23
1 13/16	1.813	4	2.58	5.16	7.74
1 7/8	1.875	4	2.76	5.52	8.28
1 15/16	1.938	4	2.95	5.90	8.85
2	2.000	4	3.14	6.28	9.42
n = Number of columns of perforations					
Minimum steel plate thickness					
* Designer may interfere to the nearest 32 nd inch to better match the needed area if desired.					

Rectangular Perforation sizing

Use only one rectangular column whenever two 2;inch diameter circular perforations cannot provide needed outlet area.

Rectangular Height = 2-inches

Rectangular Width = Required Area per Row / 2"

Rectangular hole Width	Min. Steel Thickness
5"	1/4 "
6"	1/4 "
7"	5/32 "
8"	5/16 "
9"	11/32 "
10"	3/8 "
> 10"	1/2 "

Figure 5—WQCV Outlets Orifice Perforation Sizing.

FOREBAY/MICRO-POOL VOLUME CALCULATIONS

POND DESIGN	ELEV	AREA (ft ²)	VOLUME (ft ³)	VOLUME _{sum} (ft ³)	VOLUME _{sum} (Ac-ft)	METHOD
Pond Presedimentation Forebay - West	6382.37	0.00	0.00	0.00	0.0000	prismoidal
	6382.40	4.68	0.05	0.05	0.0000	
	6382.60	35.33	3.52	3.57	0.0001	
	6382.80	66.78	10.05	13.62	0.0003	
	6382.90	76.27	7.15	20.76	0.0005	

WQCV(Ac-ft)= 0.0168

V_{forebay}(Ac-ft)= 0.0004

Elev (ft) = 6382.87

50% of total flow enters south forebay. Therefore only 50% of the required forebay volume is being provided at this location.

POND DESIGN	ELEV	AREA (ft ²)	VOLUME (ft ³)	VOLUME _{sum} (ft ³)	VOLUME _{sum} (Ac-ft)	METHOD
Pond Presedimentati on Forebay - East	6383.44	0.00	0	0	0.0000	prismoidal
	6383.60	24.04	1.31	1.31	0.0000	
	6383.80	55.18	7.71	9.02	0.0002	
	6384.00	82.84	13.71	22.72	0.0005	

WQCV(Ac-ft)= 0.0168

V_{forebay}(Ac-ft)= 0.0004

Elev (ft) = 6383.94

50% of total flow enters north forebay. Therefore only 50% of the required forebay volume is being provided at this location.

POND DESIGN	ELEV	AREA (ft ²)	VOLUME (ft ³)	VOLUME _{sum} (ft ³)	VOLUME _{sum} (Ac-ft)	METHOD
Pond Sedimentation Micro-Pool	6376.80	16.00	0	0	0	prismoidal
	6377.00	16.00	3.20	3.20	0.0001	
	6377.50	16.00	8.00	11.20	0.0003	
	6378.00	16.00	8.00	19.20	0.0004	
	6378.50	16.00	8.00	27.20	0.0006	
Bottom Stage Storage VBS	6379.00	16.00	8.00	35.20	0.0008	
	6379.50	16.00	8.00	43.20	0.0010	

WQCV(Ac-ft)= 0.0168

V_{Bottom Stage}(Ac-ft)= 0.0001

Elev (ft) = 6377.03

Note: Micro-pool to be 1/2 depth of the top stage depth, or 2.5', whichever is greater.

Top stage depth = 3.3', therefore micro-pool is 2.50' deep.

High Prairie Farms Maint. Facility - Pond Forebay Outlets
 SUBJECT DV1310 TAN
 JOB NO. DESIGNED BY
 DATE 8/28/07 CHECKED BY

NOLTE

Forebays should drain in 3-5 minutes

$$V_{\text{Forebay}} = 0.0004 \text{ ac-ft} = 18.3 \text{ cf}$$

$$Q_{3\text{min}} = \frac{18.3 \text{ cf}}{3 \text{ min}} \times \frac{1 \text{ min}}{60 \text{ sec}} = 0.102 \text{ cfs}$$


$$Q_{5\text{min}} = \frac{18.3 \text{ cf}}{3 \text{ min}} \times \frac{1 \text{ min}}{60 \text{ sec}} = 0.061 \text{ cfs}$$

$$Q_{\text{weir}} = C b h^{3/2} \quad C = 3.33 \quad h = 0.5'$$

$$b = \frac{Q}{C h^{3/2}} \quad b_{3\text{min}} = \frac{0.102}{3.33 \times 0.5^{3/2}} = 0.086' = 1.0''$$

$$b_{5\text{min}} = \frac{0.061}{3.33 \times 0.5^{3/2}} = 0.052' = 0.6''$$

* Use 2" wide curb cut due to clogging concerns

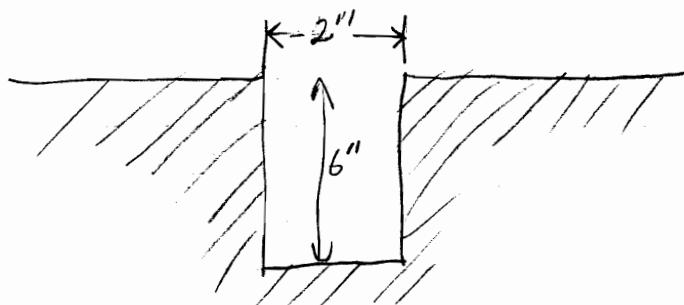

Worksheet for Pond Emergency Overflow

Project Description

Solve For Headwater Elevation

Input Data

Discharge	1.350 ft ³ /s
Crest Elevation	6383.25 ft
Tailwater Elevation	6382.40 ft
Crest Surface Type	Gravel
Crest Breadth	5.00 ft
Crest Length	10.00 ft

Results

Headwater Elevation	6383.39 ft
Headwater Height Above Crest	0.14 ft
Tailwater Height Above Crest	-0.85 ft
Weir Coefficient	2.56 US
Submergence Factor	1.00
Adjusted Weir Coefficient	2.56 US
Flow Area	202.39 in ²
Velocity	0.96 ft/s
Wetted Perimeter	10.28 ft
Top Width	10.00 ft

Cross Section for Pond Emergency Overflow


Project Description

Solve For Headwater Elevation

Input Data

Discharge	1.350 ft ³ /s
Headwater Elevation	6383.39 ft
Crest Elevation	6383.25 ft
Tailwater Elevation	6382.40 ft
Crest Surface Type	Gravel
Crest Breadth	5.00 ft
Crest Length	10.00 ft

Cross Section Image

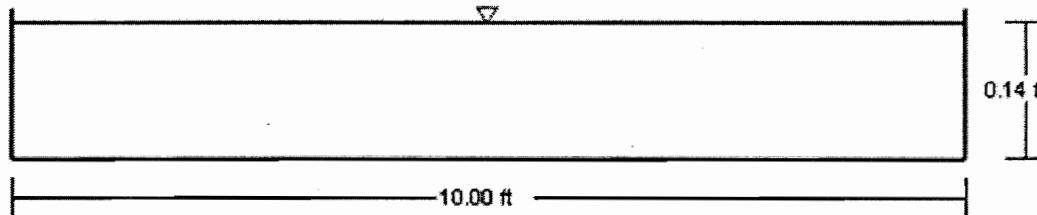

V: 10 
H: 1

APPENDIX E

MAPS/PLANS

1697 Cole Boulevard, Suite 200
 Golden, CO 80401
 Tel: (303) 239-5400
 Fax: (303) 239-5454

BROWN AND
 CALDWELL

January 11, 2008

Ms. Kati Carter
 Douglas County Community Development Department
 Planning Division
 100 Third Street
 Castle Rock, CO 80104

Subject: 9455 Democrat Road (High Prairie Farms Maintenance Facility), SP07-104

Dear Ms. Carter:

Brown and Caldwell reviewed the subject project on behalf of the Cherry Creek Basin Water Quality Authority (Authority). As the watershed consultant for the Authority, Brown and Caldwell's review focuses on point and non-point source pollutant impacts and water quality considerations related to the proposed project.

Considerations

The proposed project warrants review by the Authority because of its location within the Cherry Creek basin and the change in land use that can impact runoff quantity and quality.


Review Comments

The Authority takes no exception to the proposed project as long as the applicant provides water quality control facilities (i.e., baseline BMPs) either on-site or by a regional facility. Facilities must be designed in accordance with the Authority's Requirements¹, Authority approved development master plans, and the Urban Drainage and Flood Control District's Major Drainageway and Outfall System Planning studies. Additional water-quality facilities are required if the project disturbs a stream preservation area or if industrial type uses are proposed that may impact quality of stormwater runoff or if the project may have a direct impact on Cherry Creek State Park. Applicant shall provide documentation in the drainage report that a regional stormwater facility was designed to accept developed-conditions runoff from the proposed project. The Authority reserves the right to comment further on the project after receiving the drainage plan. Please provide a copy of the drainage and stormwater quality plan with subsequent submittals.

If you have any questions, please call us at (303) 239-5400.

Very truly yours,

BROWN AND CALDWELL

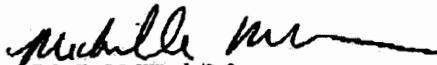
 Michelle M. Wind, P.E.
 Project Manager


 William P. Ruzzo, P.E.
 Project Engineer

cc: Chuck Reid, Manager, Authority

¹ Cherry Creek Basin Water Quality Authority. February 2000. *Cherry Creek Reservoir Watershed Stormwater Quality Requirements*.

Environmental Engineers & Consultants

F:\Data\GEN\CCBWQA\132130 - CCBWQA - 2007\040 Dev Rev\2007\Carte-2-9455DemocratRoad.doc

January 30, 2008



Michelle M. Wind, P.E.
Project Manager
1697 Cole Blvd., Suite 200
Golden, CO 80401

RE: 9455 Democrat Road (High Prairie Farms Maintenance Facility), SP07-104

Dear Mrs. Wind:

This letter is in reference to the comments received from the Cherry Creek Basin Water Quality Authority (Authority) on the first submittal of the 9455 Democrat Road plans and reports, dated January 11, 2008.

Review Comments

1. The Authority takes no exception to the proposed project as long as the applicant provides water quality control facilities (i.e., baseline BMPs) either on-site or by a regional facility. Facilities must be designed in accordance with the Authority's Requirements, Authority approved development master plans, and the Urban Drainage and Flood Control District's Major Drainageway and Outfall System Planning Studies.

Response: Water quality facilities will be provided on-site and have been designed in accordance with current UDFCD standards. These include a water quality volume in the on-site detention basin, forebays and a micropool. The project will be constructed following current Douglas County Grading, Erosion and Sediment Control procedures to ensure water quality during construction.

2. Additional water-quality facilities are required if the project disturbs a stream preservation area or if industrial type uses are proposed that may impact quality of stormwater runoff or if the project may have a direct impact on Cherry Creek State Park.

Response: The project does not meet the above listed criteria for additional water-quality facilities.

3. Applicant shall provide documentation in the drainage report that a regional stormwater facility was designed to accept developed-conditions runoff from the proposed project.

Response: Stormwater detention will be provided on site to accept developed-conditions runoff. This has been documented in the drainage report.

4. The Authority reserves the right to comment further on the project after receiving the drainage plan. Please provide a copy of the drainage and stormwater quality plan with subsequent submittals.

Response: The Phase III Drainage Report is attached.

Please contact us if you have any questions or concerns regarding this matter. Sincerely,

NOLTE ASSOCIATES, INC.

A handwritten signature in black ink, appearing to read "Gary Iwata".

Gary Iwata, P.E.
Engineering Manager

CC: Kati Carter, Project Planner, Douglas County Planning Division
David Foster, Plan West, Inc.

N:\dv\1310\Documents\High Prairie Farms\CommentResponses.doc

NOLTE ASSOCIATES, INC.

8000 SOUTH CHESTER STREET, SUITE 200
CENTENNIAL, CO 80112-3520
303.220.6400 TEL 303.220.9001 FAX
WWW.NOLTE.COM

CONSTRUCTION PLANS

THE PINERY HIGH PRAIRIE FARMS MAINTENANCE FACILITY

PROPOSED GRADING AND STORM DRAINAGE IMPROVEMENTS


County of Douglas, State of Colorado

GENERAL NOTES

1. THE DOUGLAS COUNTY ENGINEER'S SIGNATURE AFFIXED TO THIS DOCUMENT INDICATES THE ENGINEERING DIVISION HAS REVIEWED THE DOCUMENT AND FOUND IT IN GENERAL CONFORMANCE WITH THE DOUGLAS COUNTY SUBDIVISION RESOLUTION OR APPROVED VARIANCES TO THOSE REGULATIONS. THE DOUGLAS COUNTY ENGINEER, THROUGH ACCEPTANCE OF THIS DOCUMENT, ASSUMES NO RESPONSIBILITY, OTHER THAN STATED ABOVE, FOR THE COMPLETENESS AND/OR ACCURACY OF THESE DOCUMENTS. THE OWNER AND ENGINEER UNDERSTAND THAT THE RESPONSIBILITY FOR THE ENGINEERING ADEQUACY OF THE FACILITIES DEPICTED IN THE DOCUMENT LIES SOLELY WITH THE REGISTERED PROFESSIONAL ENGINEER WHOSE STAMP AND SIGNATURE IS AFFIXED TO THE DOCUMENT.
2. ALL MATERIAL AND WORKMANSHIP SHALL BE SUBJECT TO INSPECTION BY THE DOUGLAS COUNTY ENGINEERING DIVISION. THE COUNTY RESERVES THE RIGHT TO ACCEPT OR REJECT ANY SUCH MATERIALS AND WORKMANSHIP THAT DOES NOT CONFORM TO ITS STANDARDS AND SPECIFICATIONS.
3. THE CONTRACTOR SHALL NOTIFY THE DOUGLAS COUNTY ENGINEERING DIVISION INSPECTION SECTION, 303-660-7487, A MINIMUM OF 48 HOURS AND A MAXIMUM OF 96 HOURS PRIOR TO STARTING CONSTRUCTION.
4. CAUTION: LOCATION OF EXISTING UTILITIES SHALL BE VERIFIED BY THE CONTRACTOR PRIOR TO ACTUAL CONSTRUCTION. FOR INFORMATION CONTACT: DENVER INTER-UTILITY GROUP 1-800-922-1987.
5. THE CONTRACTOR SHALL HAVE ONE (1) SIGNED COPY OF THE PLANS (ACCEPTED BY THE DOUGLAS COUNTY ENGINEER) AND ONE (1) COPY OF THE ROADWAY DESIGN AND CONSTRUCTION STANDARDS AT THE JOB SITE AT ALL TIMES.
6. A PLAN FOR TRAFFIC CONTROL DURING CONSTRUCTION SHALL BE SUBMITTED TO DOUGLAS COUNTY FOR ACCEPTANCE WITH THE PERMIT APPLICATION. AN EXCAVATION OR PUBLIC IMPROVEMENTS CONSTRUCTION PERMIT WILL NOT BE ISSUED WITHOUT AN APPROVED TRAFFIC CONTROL PLAN FOR TRAFFIC CONTROL DURING CONSTRUCTION.
7. THE CONSTRUCTION PLANS SHALL BE CONSIDERED VALID FOR TWO (2) YEARS FROM THE DATE OF COUNTY ACCEPTANCE AFTER WHICH TIME THESE PLANS SHALL BE VOID AND WILL BE SUBJECT TO RE-REVIEW AND RE-ACCEPTANCE BY DOUGLAS COUNTY.
8. CONTRACTOR SHALL NOTIFY DOUGLAS COUNTY ENGINEERING INSPECTION WHEN WORKING OUTSIDE OF THE PUBLIC RIGHT-OF-WAY ON ANY FACILITY WHICH WILL BE CONVEYED TO THE COUNTY, URBAN DRAINAGE AND FLOOD CONTROL DISTRICT, OR OTHER SPECIAL DISTRICT FOR MAINTENANCE (STORM SEWER, ENERGY DISSIPATER, DETENTION OUTLET STRUCTURE, OR OTHER DRAINAGE INFRASTRUCTURE BY THE COUNTY AND/OR URBAN DRAINAGE). FAILURE TO NOTIFY ENGINEERING INSPECTION TO ALLOW THEM TO INSPECT THE CONSTRUCTION MAY RESULT IN NON-ACCEPTANCE OF THE FACILITY/INFRASTRUCTURE BY THE COUNTY AND/OR URBAN DRAINAGE.
9. INSPECTION: CONSTRUCTION SHALL NOT BEGIN UNTIL A PERMIT HAS BEEN ISSUED. IF A DOUGLAS COUNTY ENGINEERING INSPECTOR IS NOT AVAILABLE AFTER PROPER NOTICE OF CONSTRUCTION ACTIVITY HAS BEEN PROVIDED, THE PERMITTEE MAY COMMENCE WORK IN THE INSPECTOR'S ABSENCE. HOWEVER, DOUGLAS COUNTY RESERVES THE RIGHT NOT TO ACCEPT THE IMPROVEMENT IF SUBSEQUENT TESTING REVEALS AN IMPROPER INSTALLATION.
10. ALL ELEVATIONS ARE ON USGS DATUM NAVD 88. RANGE POINT OR MONUMENT SHALL BE SHOWN ON CONSTRUCTION PLANS.

STORM DRAIN NOTES

1. PUBLIC STORM SEWER SHALL BE REINFORCED CONCRETE PIPE (RCP), MINIMUM CLASS III EXCEPT WHERE NOTED OTHERWISE.
2. CONTRACTOR SHALL VERIFY HORIZONTAL AND VERTICAL LOCATION OF EXISTING STORM SEWER POINTS OF CONNECTIONS PRIOR TO THE CONSTRUCTION OF ANY PROPOSED STORM SEWER AND NOTIFY THE COUNTY AND ENGINEER WITH ANY DISCREPANCIES.
3. ALL STORM SEWER SHALL HAVE PIPE BEDDING AS SHOWN ON FIGURE 9.1a AND 9.1b PER DOUGLAS COUNTY ROADWAY DESIGN AND CONSTRUCTION STANDARDS MANUAL.
4. MANHOLE BARRELS AND CONES SHALL BE CONSTRUCTED OF PRECAST CONCRETE. CAST-IN-PLACE MANHOLE BASES AND INLETS ARE REQUIRED.
5. PRECAST MANHOLES AND RISERS SHALL BE MANUFACTURED IN CONFORMITY WITH ASTM DESIGNATION C-478. ALL CONES SHALL BE ECCENTRIC.
6. CONTRACTOR SHALL ATTACH FLARED-END SECTIONS PER DOUGLAS COUNTY CRITERIA WITH JOINT FASTENERS ON FES AND THE LAST TWO SECTIONS OF RCP PIPE.
7. NO BACKFILL MATERIAL SHALL BE PLACED ABOVE THE SPRINGLINE OF THE PIPE UNTIL A DOUGLAS COUNTY REPRESENTATIVE HAS AUTHORIZED BACKFILLING. IT SHALL BE THE RESPONSIBILITY OF THE CONTRACTOR TO NOTIFY DOUGLAS COUNTY 48 HOURS IN ADVANCE OF THE PROPOSED BACKFILL OPERATIONS SO THAT A DOUGLAS COUNTY REPRESENTATIVE MAY INSPECT THE PIPE AND THE BEDDING PRIOR TO BACKFILLING.
8. STORM DRAINAGE MANHOLES SHALL BE IMPRINTED WITH "STORM" ON THE COVER.
9. ALL RCP STORM SEWER MUST USE WATERTIGHT O-RING GASKETS.
10. EPOXY COATED REBAR SHALL BE USED IN THE CONSTRUCTION OF ALL INLETS PER CDOT M & S STANDARDS M-604-10, 11, 12, AND 13.
11. CLASS D CONCRETE SHALL BE USED FOR THE CONSTRUCTION OF ALL DRAINAGE STRUCTURES.
12. TWO (2) MANHOLE ACCESS POINTS ARE REQUIRED ON ALL TYPE 'R' INLETS GREATER THAN OR EQUAL TO TEN (10) FEET IN LENGTH, PER CDOT M & S STANDARD M-604-12.

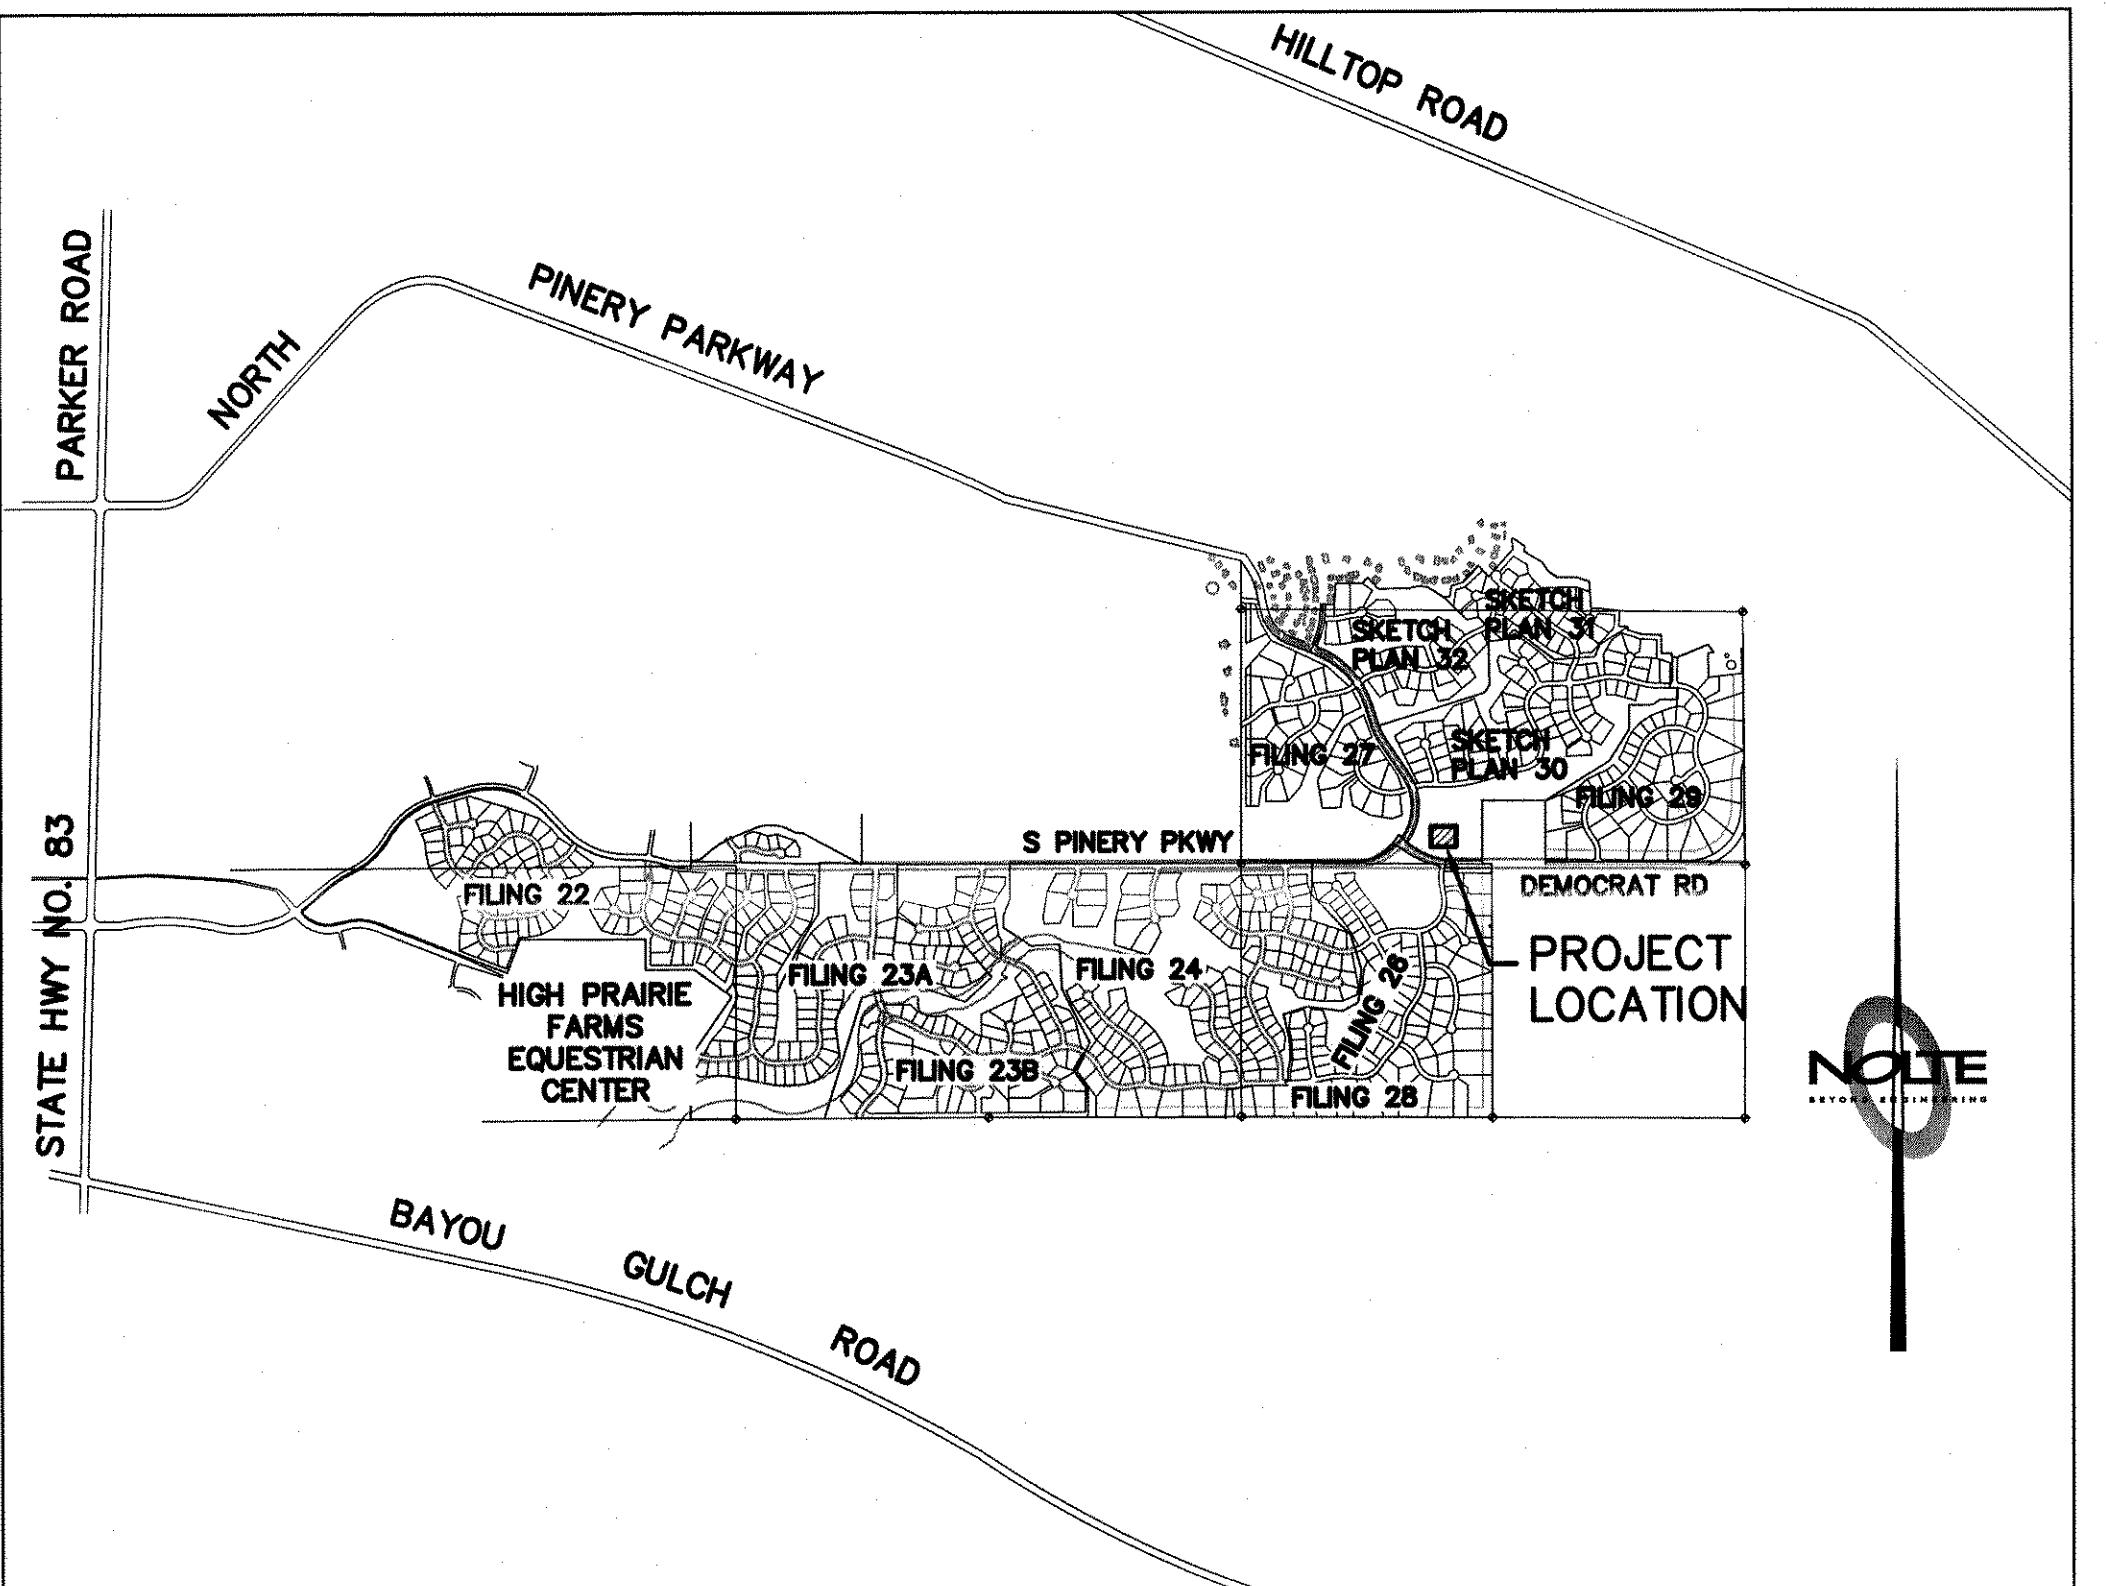

VICINITY MAP

SCALE 1"2000"

BASIS OF BEARINGS

THE BEARINGS ARE BASED ON THE SOUTHERLY LINE OF THE SOUTHEAST QUARTER OF SECTION 13, TOWNSHIP 7 SOUTH, RANGE 66 WEST OF THE SIXTH PRINCIPAL MERIDIAN. SAID LINE IS MONUMENTED ON THE WEST BY A 3 1/2" ALUMINUM CAPPED MONUMENT STAMPED "T7S R66W 13/24 1999 PLS 28656" AND ON THE EAST BY A 3 1/2" ALUMINUM CAPPED MONUMENT STAMPED "T7S R66W R65W 13/18/24/19 1999 PLS 28656" AS SHOWN HEREON. THE BEARING OF SAID LINE IS SOUTH 89°51'18" WEST, WITH ALL BEARINGS CONTAINED HEREIN RELATIVE THERETO.

BENCHMARK

THE BENCHMARK IS A 2 1/2" BRASS CAP STAMPED "CP #13, WSSI" LOCATED NEAR THE NORTH RIGHT-OF-WAY LINE OF SOUTH PINERY PARKWAY APPROXIMATELY 925 FEET EAST OF THE NORTH-SOUTH CENTERLINE OF SECTION 13, TOWNSHIP 7 SOUTH, RANGE 66 WEST OF THE 6TH PRINCIPAL MERIDIAN. ELEVATION = 6301.82, DOUGLAS COUNTY GPS NETWORK DATUM.

KEY CONTACTS

GARY IWATA
NOLTE AND ASSOCIATES, INC. (303) 220-6400

DAVE PERKINS
HIGH PRAIRIE FARMS METRO DISTRICT (303) 472-8120


BILL MORGAN
PINERY WATER & WASTE WATER DISTRICT (303) 841-2797

UTILITY NOTIFICATION
INTER-UTILITY GROUP 1-800-922-1987

SHEET INDEX

1	TS	TITLE SHEET
2	DT1	DETAILS
3	DT2	DETAILS
4	GR1	OVERALL GRADING PLAN
5	DR1	HISTORIC & PROPOSED DRAINAGE MAP
6	DR2	STORM DRAIN & OUTLET STRUCTURE DETAILS
7	DR3	DETENTION POND - FOREBAY DETAILS

I HEREBY AFFIRM THAT THESE CONSTRUCTION PLANS FOR THE PINERY HIGH PRAIRIE FARMS MAINTENANCE FACILITY WERE PREPARED BY ME (OR UNDER MY DIRECT SUPERVISION) IN ACCORDANCE WITH THE REQUIREMENTS OF THE DOUGLAS COUNTY ROADWAY DESIGN AND CONSTRUCTION STANDARDS. THE DOUGLAS COUNTY STORM DRAINAGE DESIGN AND TECHNICAL CRITERIA.

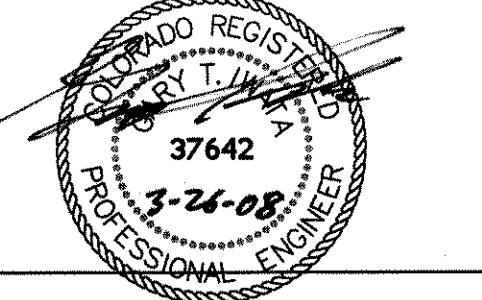


GARY IWATA
REGISTERED PROFESSIONAL ENGINEER
STATE OF COLORADO NO. 37642
NOLTE ASSOCIATES, INC.
8000 S. CHESTER ST., SUITE 200,
CENTENNIAL, CO. 80112
(303) 220-6400

RECORD COPY




1-800-922-1987
CALL 2 BUSINESS DAYS IN ADVANCE
BEFORE YOU PLAN TO EXCAVATE
FOR THE MARKING OF UNDERGROUND
MEMBER UTILITIES.

RECORD COPY

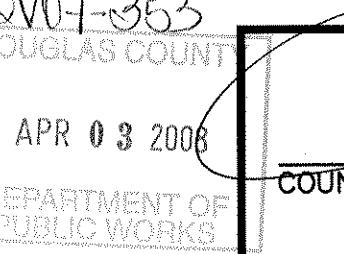

RECORD COPY

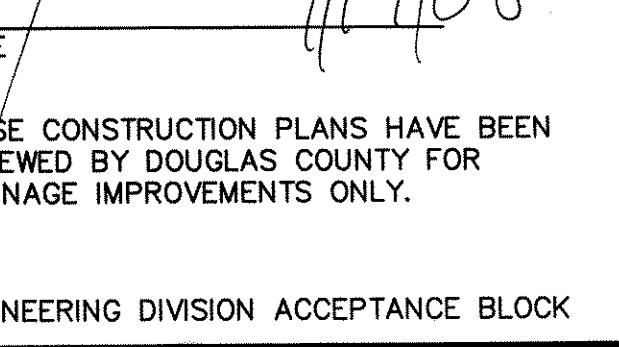


The engineer preparing these plans will not be responsible for, or liable for, unauthorized changes to or uses of these plans. All changes to the plans must be in writing and must be approved by the proper officer of these plans.

DATE:	3/21/08	TIME:	10:33:11 AM	DRAWING NAME:	01-CD-TSDN
DESIGNER:	###	PROJ. NR.:	###	PLOTTED BY:	HOUSEK
SERVER:	PATH: N:\\D1000\\DOUG\\D1000\\PINERY\\PRAIRIE FARMS				
ATTS:	246350				
PREPARED FOR: HIGH PRAIRIE FARMS METRO DISTRICT					
TITLE SHEET					
DATE SUBMITTED: FEB. 2008					
NOTICE					
BEYOND ENGINEERING					
8000 S. Chester Street, Suite 200 Centennial, CO 80112 www.nolte.com					
NO EXCAVATION					
CALL UTILITY NOTIFICATION CENTER OF COLORADO 8000 S. Chester Street, Suite 200 303.220.6400 FAX 303.220.9001					
RECORD COPY					
RECORD COPY					
RECORD COPY					
RECORD COPY					

The engineer preparing these plans will not be responsible for, or liable for, unauthorised changes to the plans or use of these plans. All changes to the plans must be in writing and must be approved by the preparer of these plans.

HIGH PRAIRIE FARMS MAINT. FACILITY CONSTRUCTION DETAILS

DATE SUBMITTED: FEB. 2008

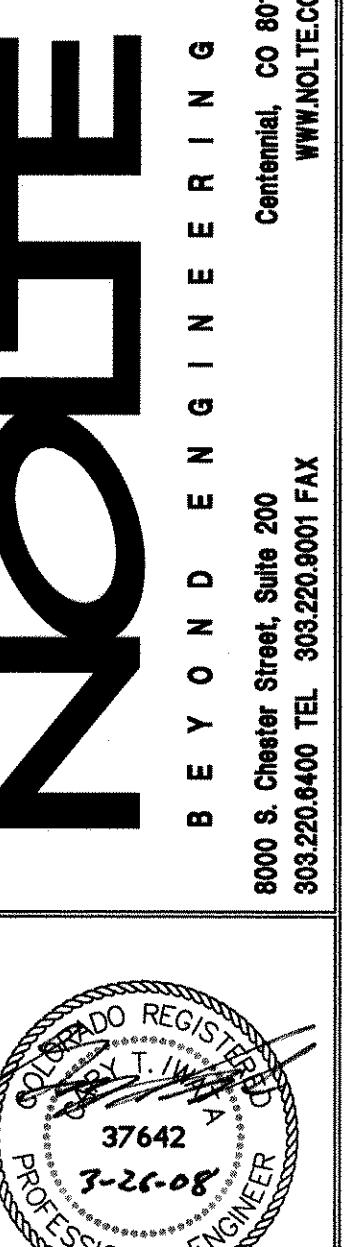

BEYOND ENGINEERING

Centennial, CO 80112


WNAOL.COM

8000 S. Chester Street, Suite 200
303/220/0400 TEL 303/220/001 FAX



37642

3-26-08

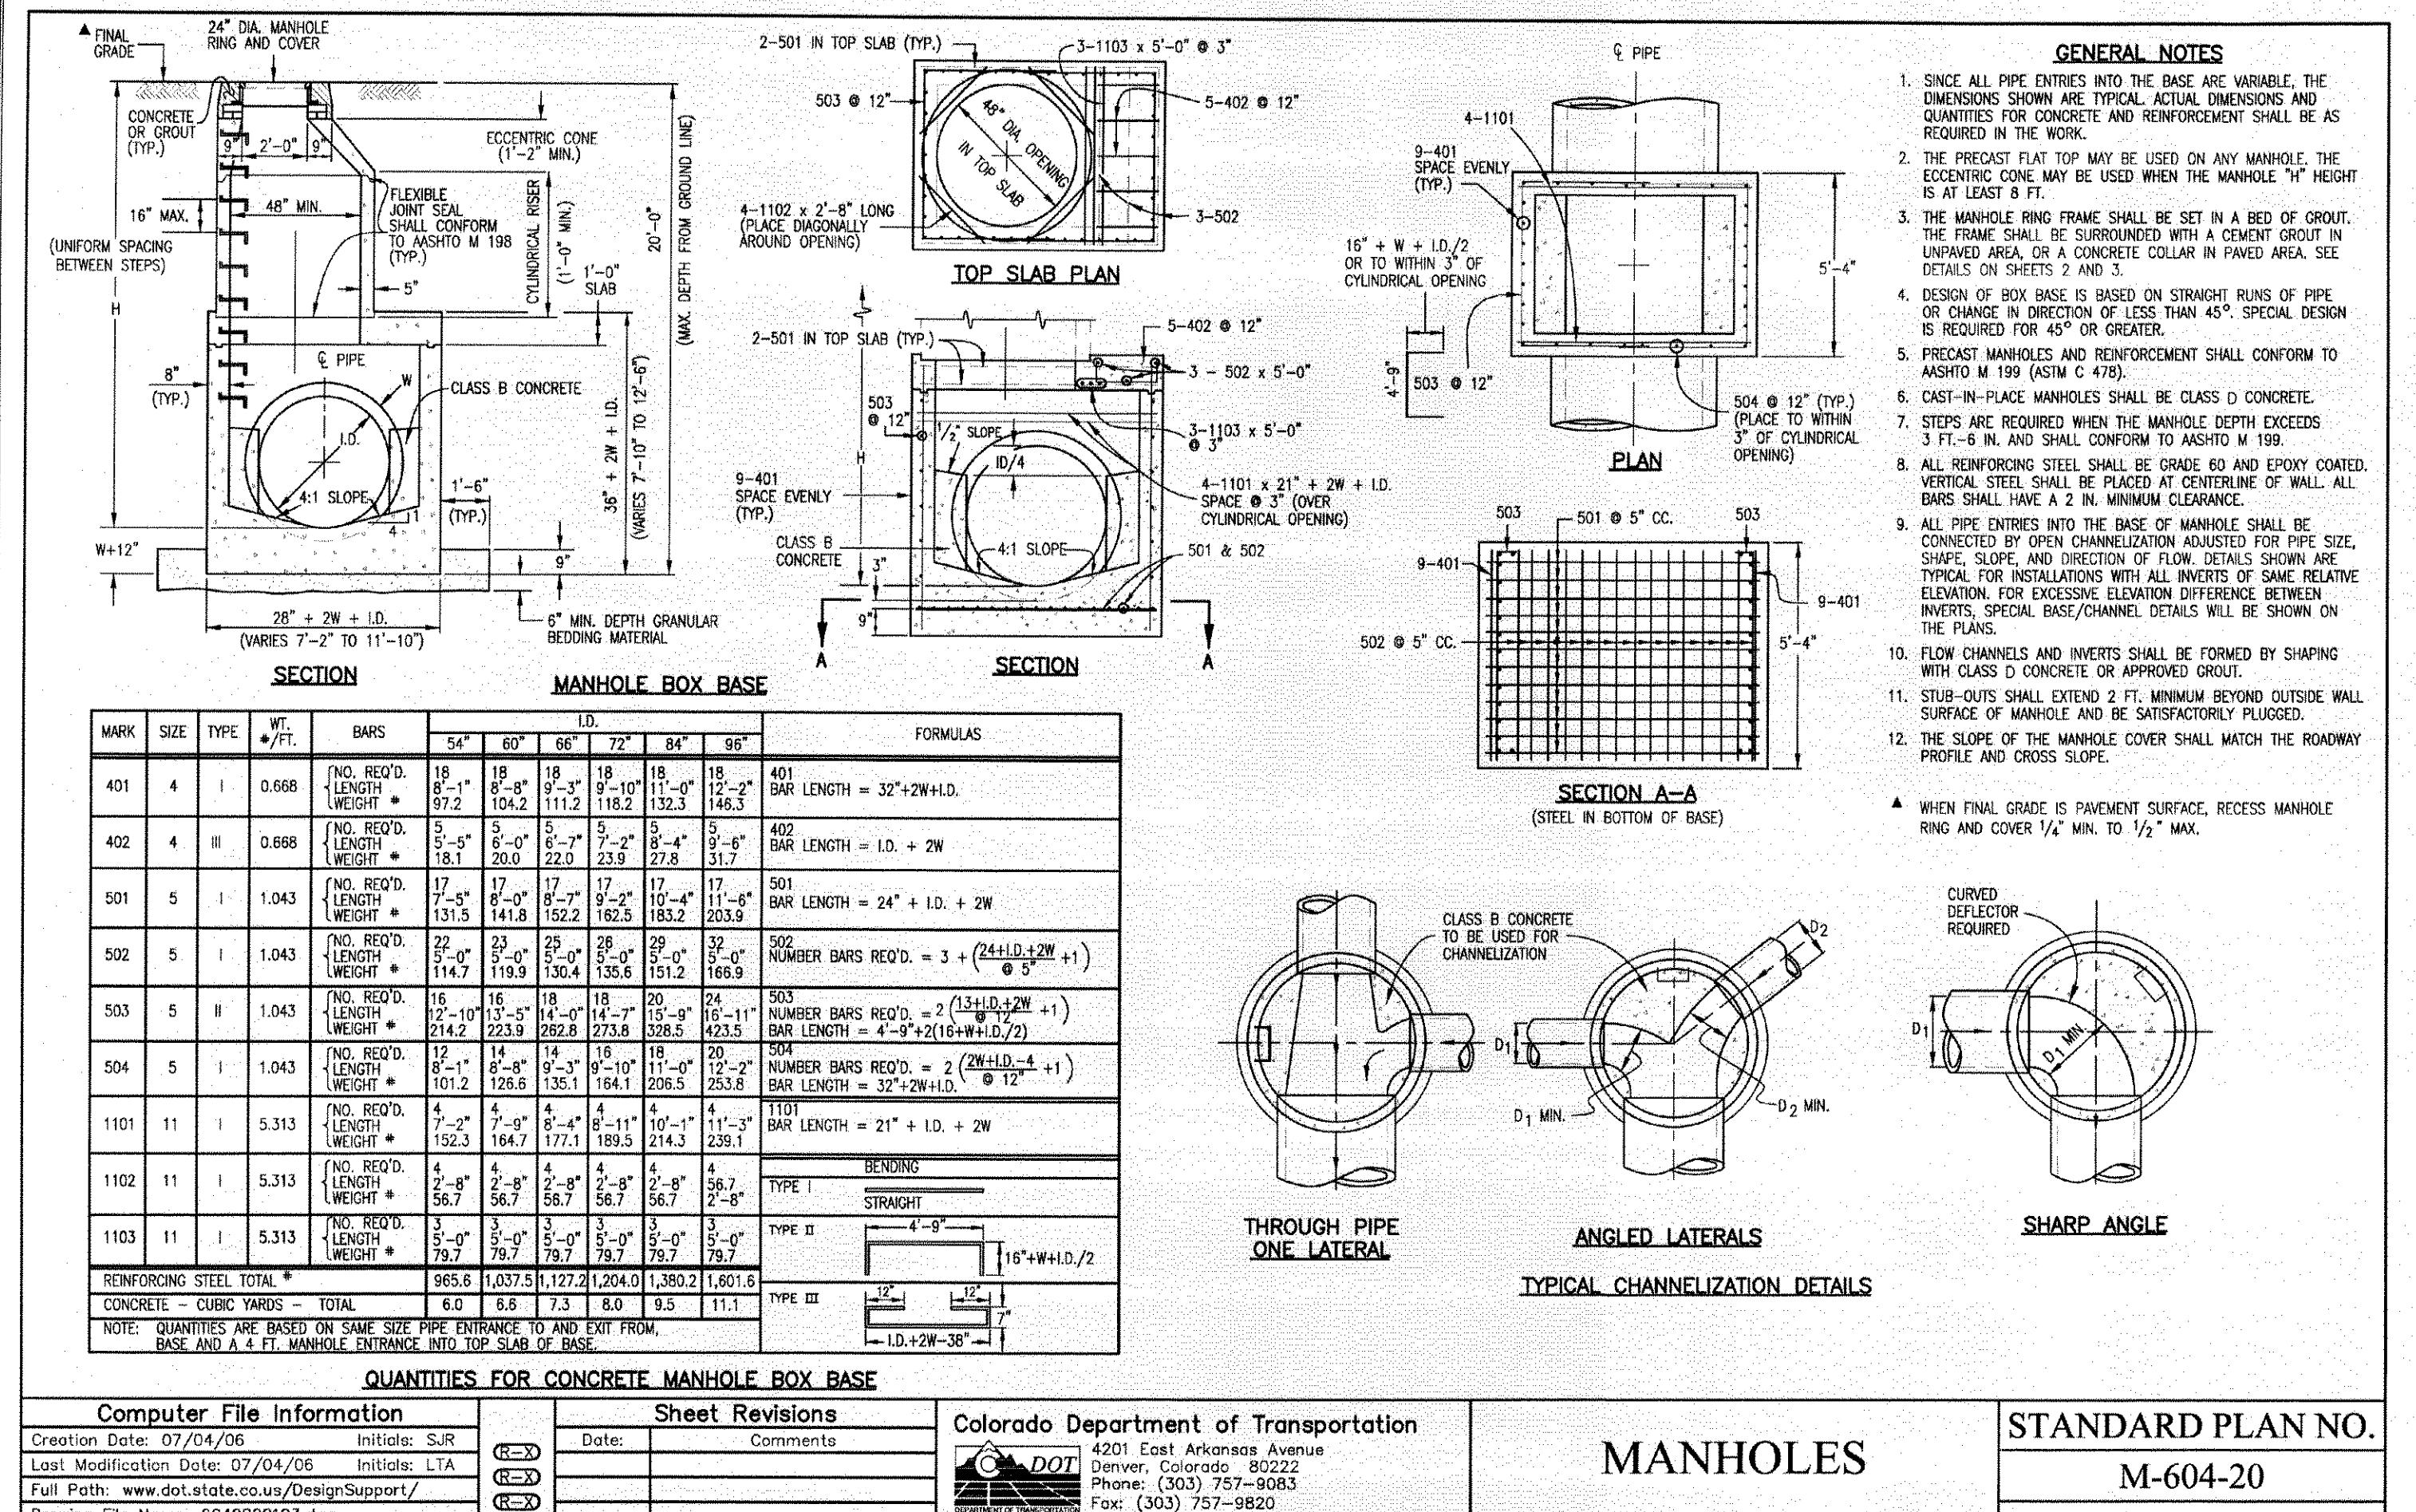

The engineer preparing these plans will not be responsible for or liable for unauthorized changes to or uses of these plans. All changes to the plans must be in writing and must be approved by the preparer of these plans.

COPYRIGHT

DATE SUBMITTED: FEB. 2008

NO.	BY	DATE	REVISIONS
1	KH	02/07/08	REvised PER DC Dwg COMMENTS

CHANGES

TO THE PLANS

BY THE PREPARER

OF THESE PLANS

DATE SUBMITTED: FEB. 2008

NO.	BY	DATE	REVISIONS
1	KH	02/07/08	REvised PER DC Dwg COMMENTS

CHANGES

TO THE PLANS

BY THE PREPARER

OF THESE PLANS

DATE SUBMITTED: FEB. 2008

NO.	BY	DATE	REVISIONS
1	KH	02/07/08	REvised PER DC Dwg COMMENTS

CHANGES

TO THE PLANS



BY THE PREPARER

OF THESE PLANS

DATE SUBMITTED: FEB. 2008

NO.	BY	DATE	REVISIONS
1	KH	02/07/08	REvised PER DC Dwg COMMENTS

CHANGES</p

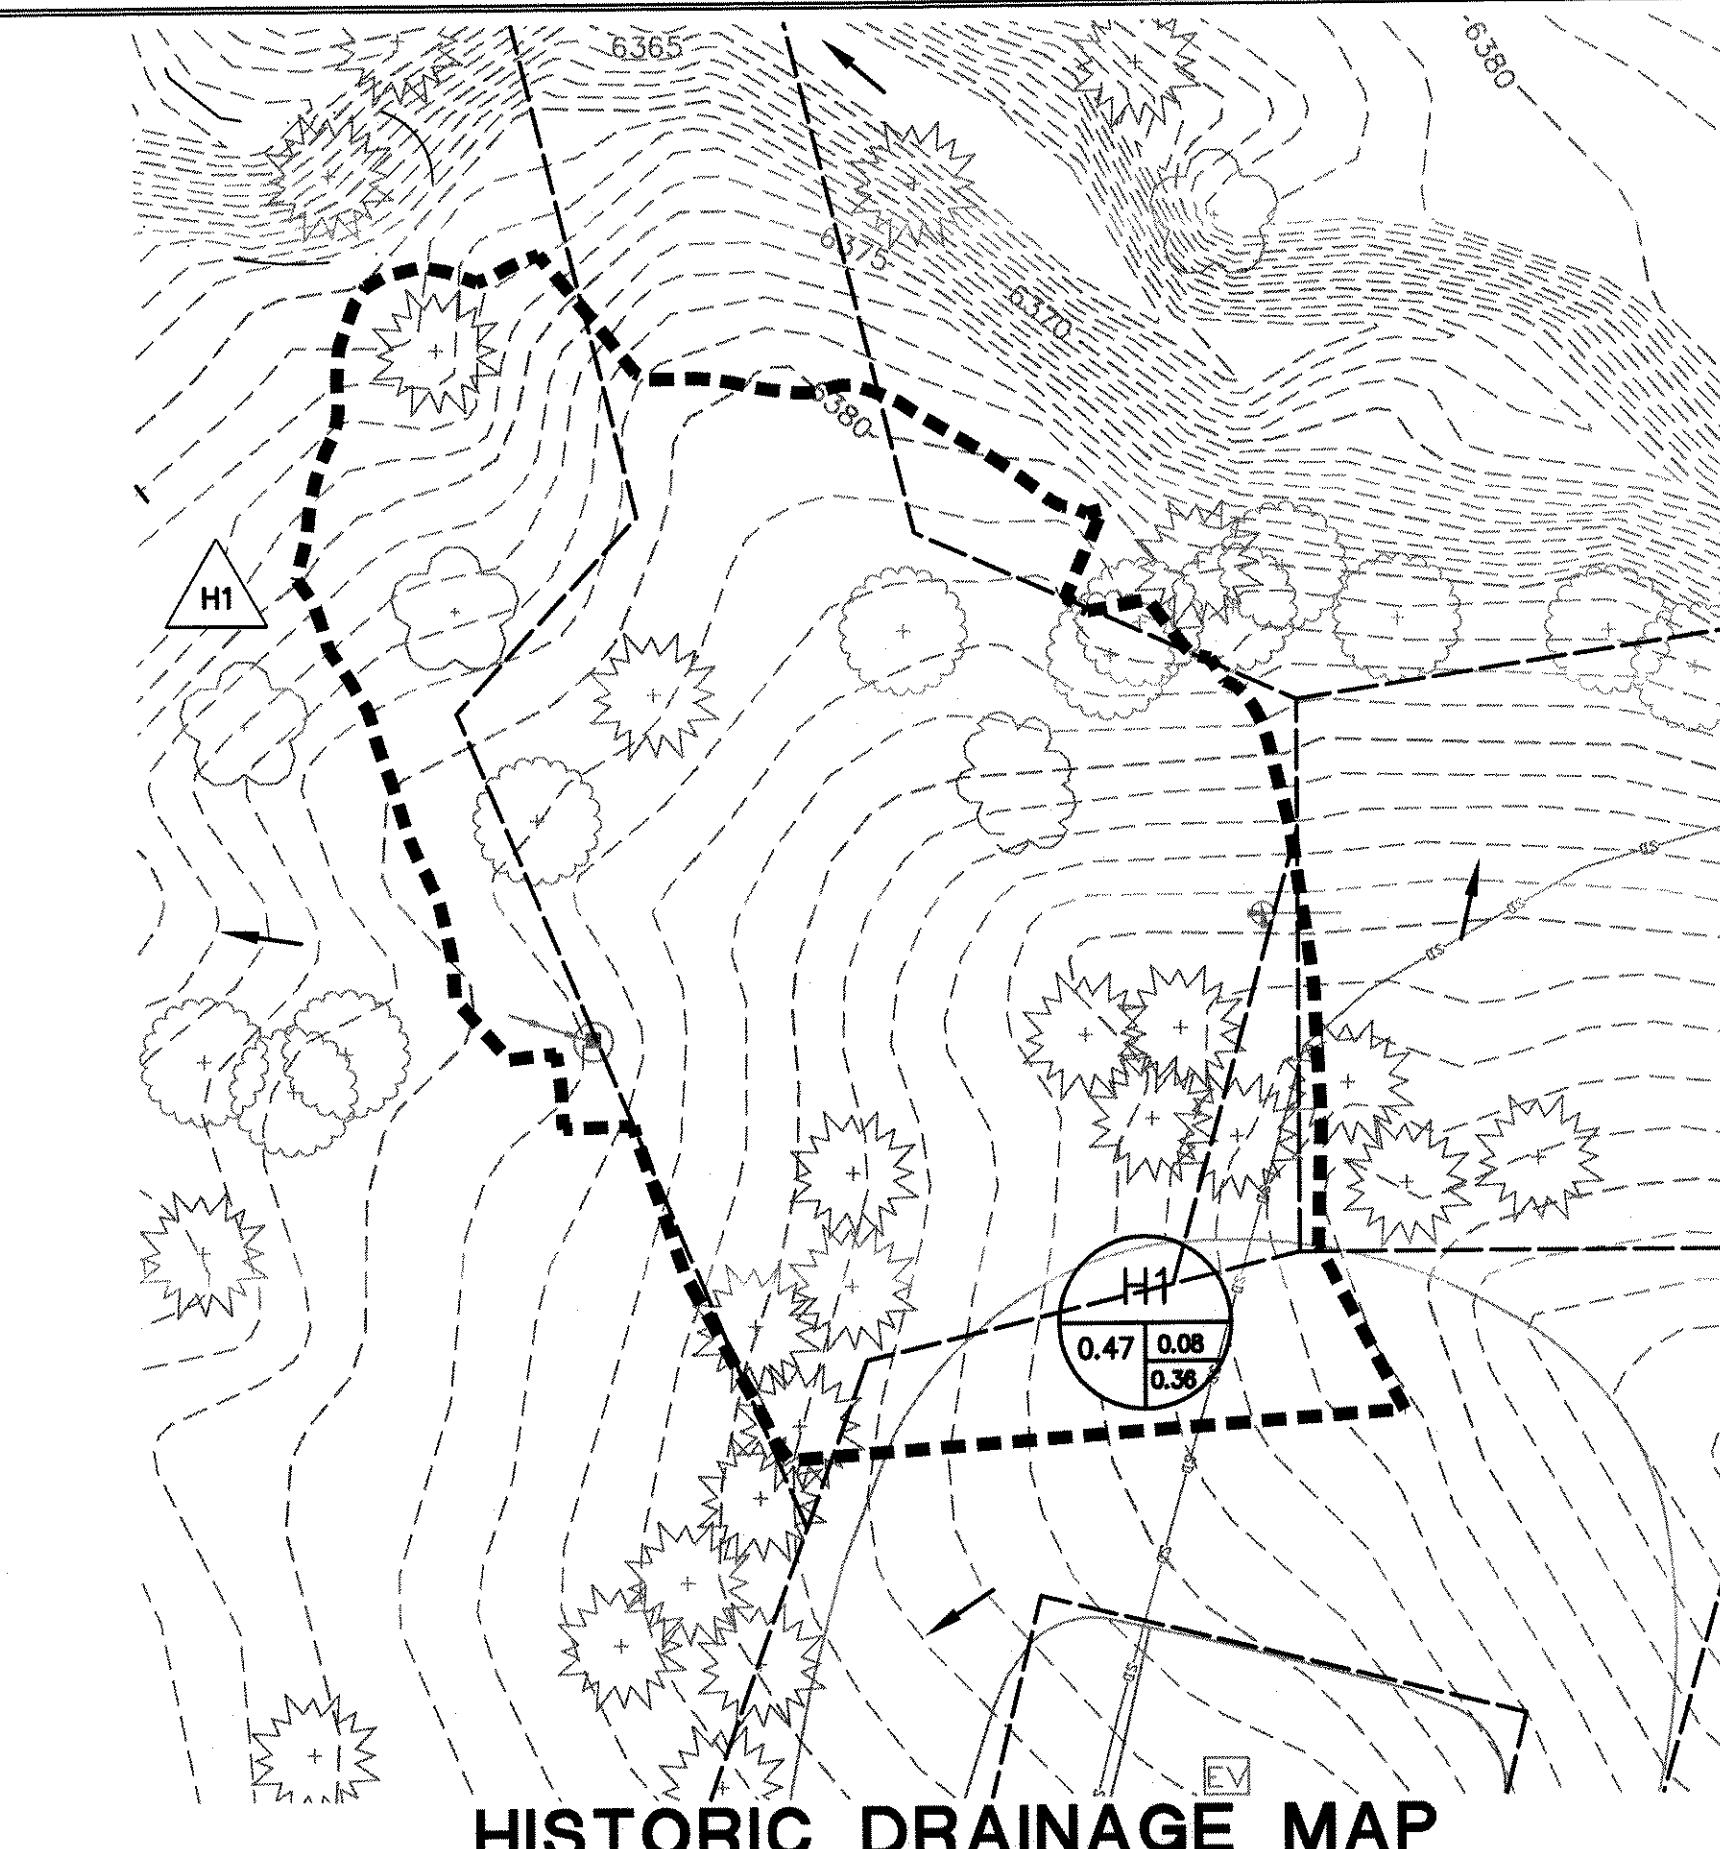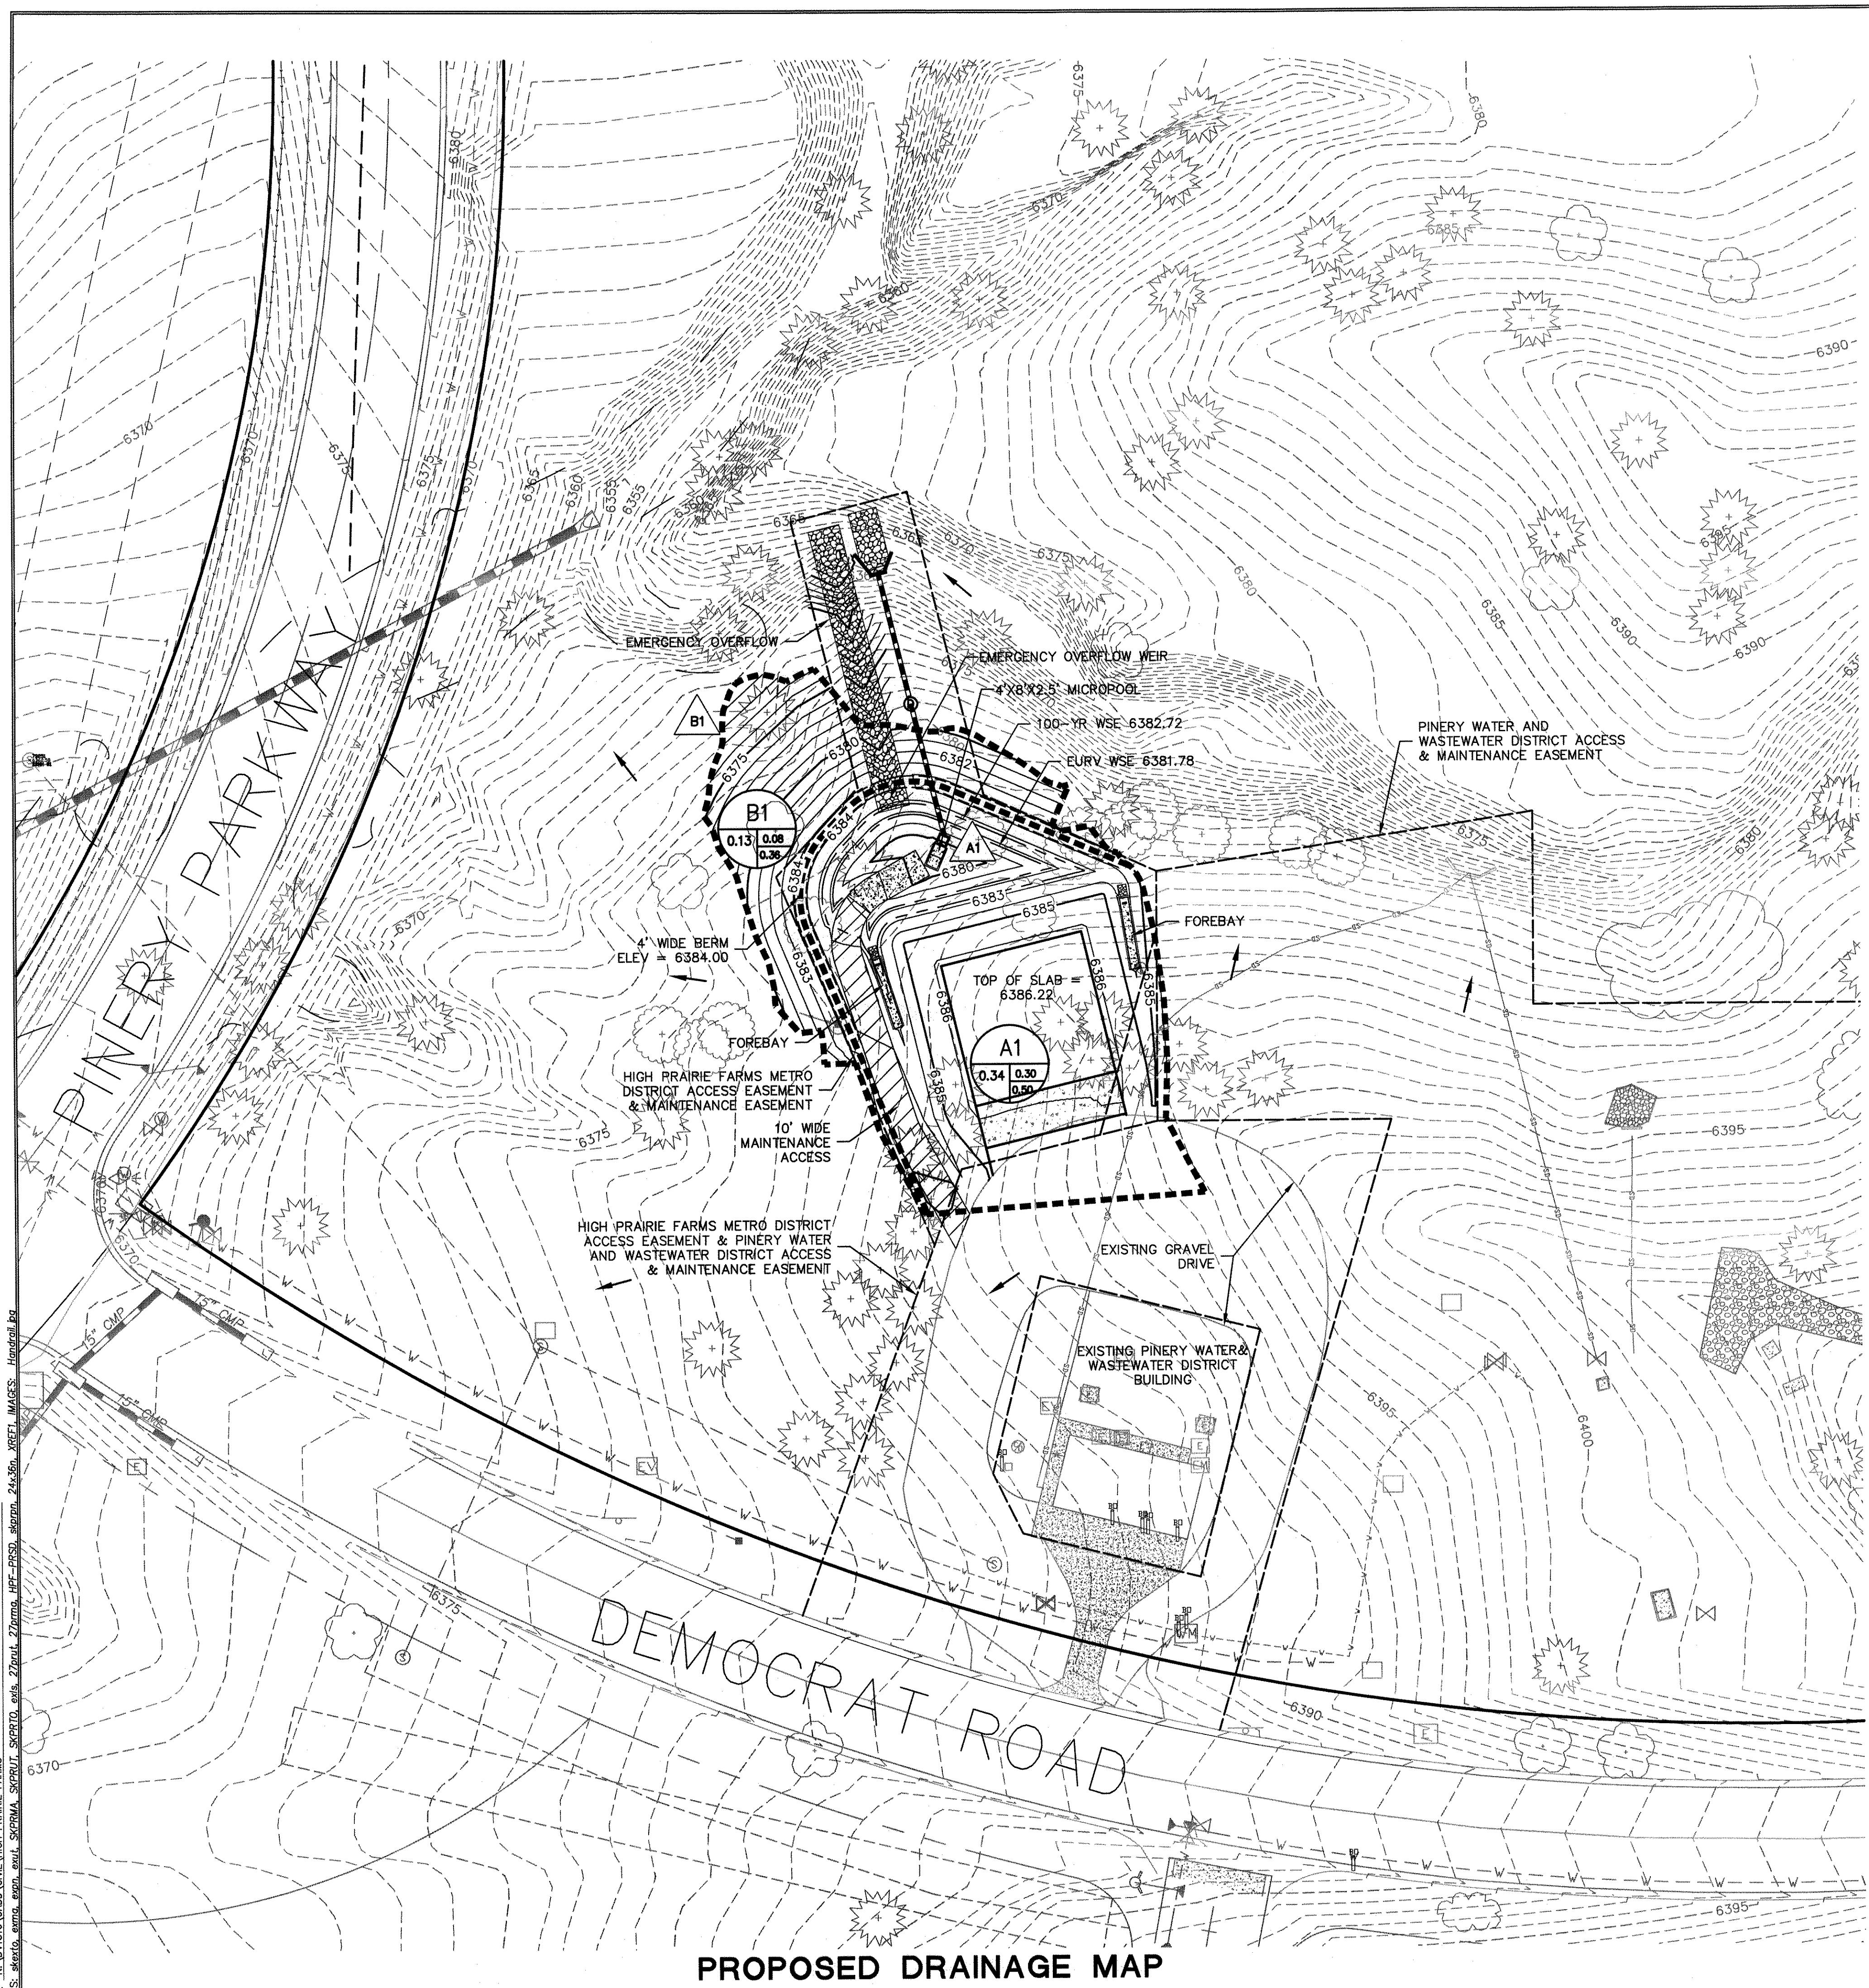


HISTORIC DRAINAGE MAP

Historic Discharge Rate Summary			
Basin ID	5 Year Flow (cfs)	10 Year Flow (cfs)	100 Year Flow (cfs)
H1	0.14	0.52	1.14

Developed Discharge Rate Summary			
Basin ID	5 Year Flow (cfs)	10 Year Flow (cfs)	100 Year Flow (cfs)
A1	0.45	0.63	1.35
B1	0.05	0.13	0.43

LEGEND

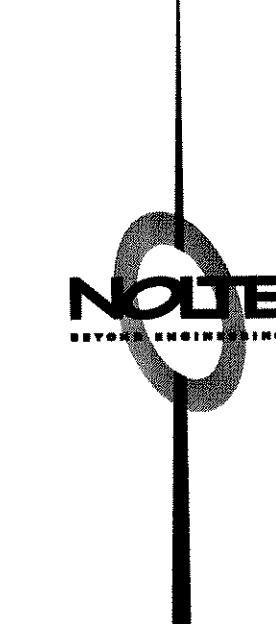

DESIGN POINT

BASIN LABEL

BASIN AREA (ACRES)

5 YR. COEFFICIENT

100 YR. COEFFICIENT

BASIN BOUNDARY

EXISTING CONTOURS

PROPOSED CONTOURS

EXISTING TREES

EXISTING STORM DRAIN

PROPOSED STORM DRAIN

EXISTING WATERLINE

EXISTING SANITARY SEWER

EXISTING ELECTRIC TRANSFORMER

EXISTING WATER VALVE

NOTE

B E Y O N D E N G I N E E R I N G


NOLTE

B E Y O N D E N G I N E E R I N G


10000 S. Chester Street, Suite 200
03.220.8400 TEL 303.220.9001 FAX

Centennial, CO 80014
WWW.NOLTE.COM


SHEET NUMBER
DR1
5 OF 7 SHEETS
JOB NUMBER
DV131005

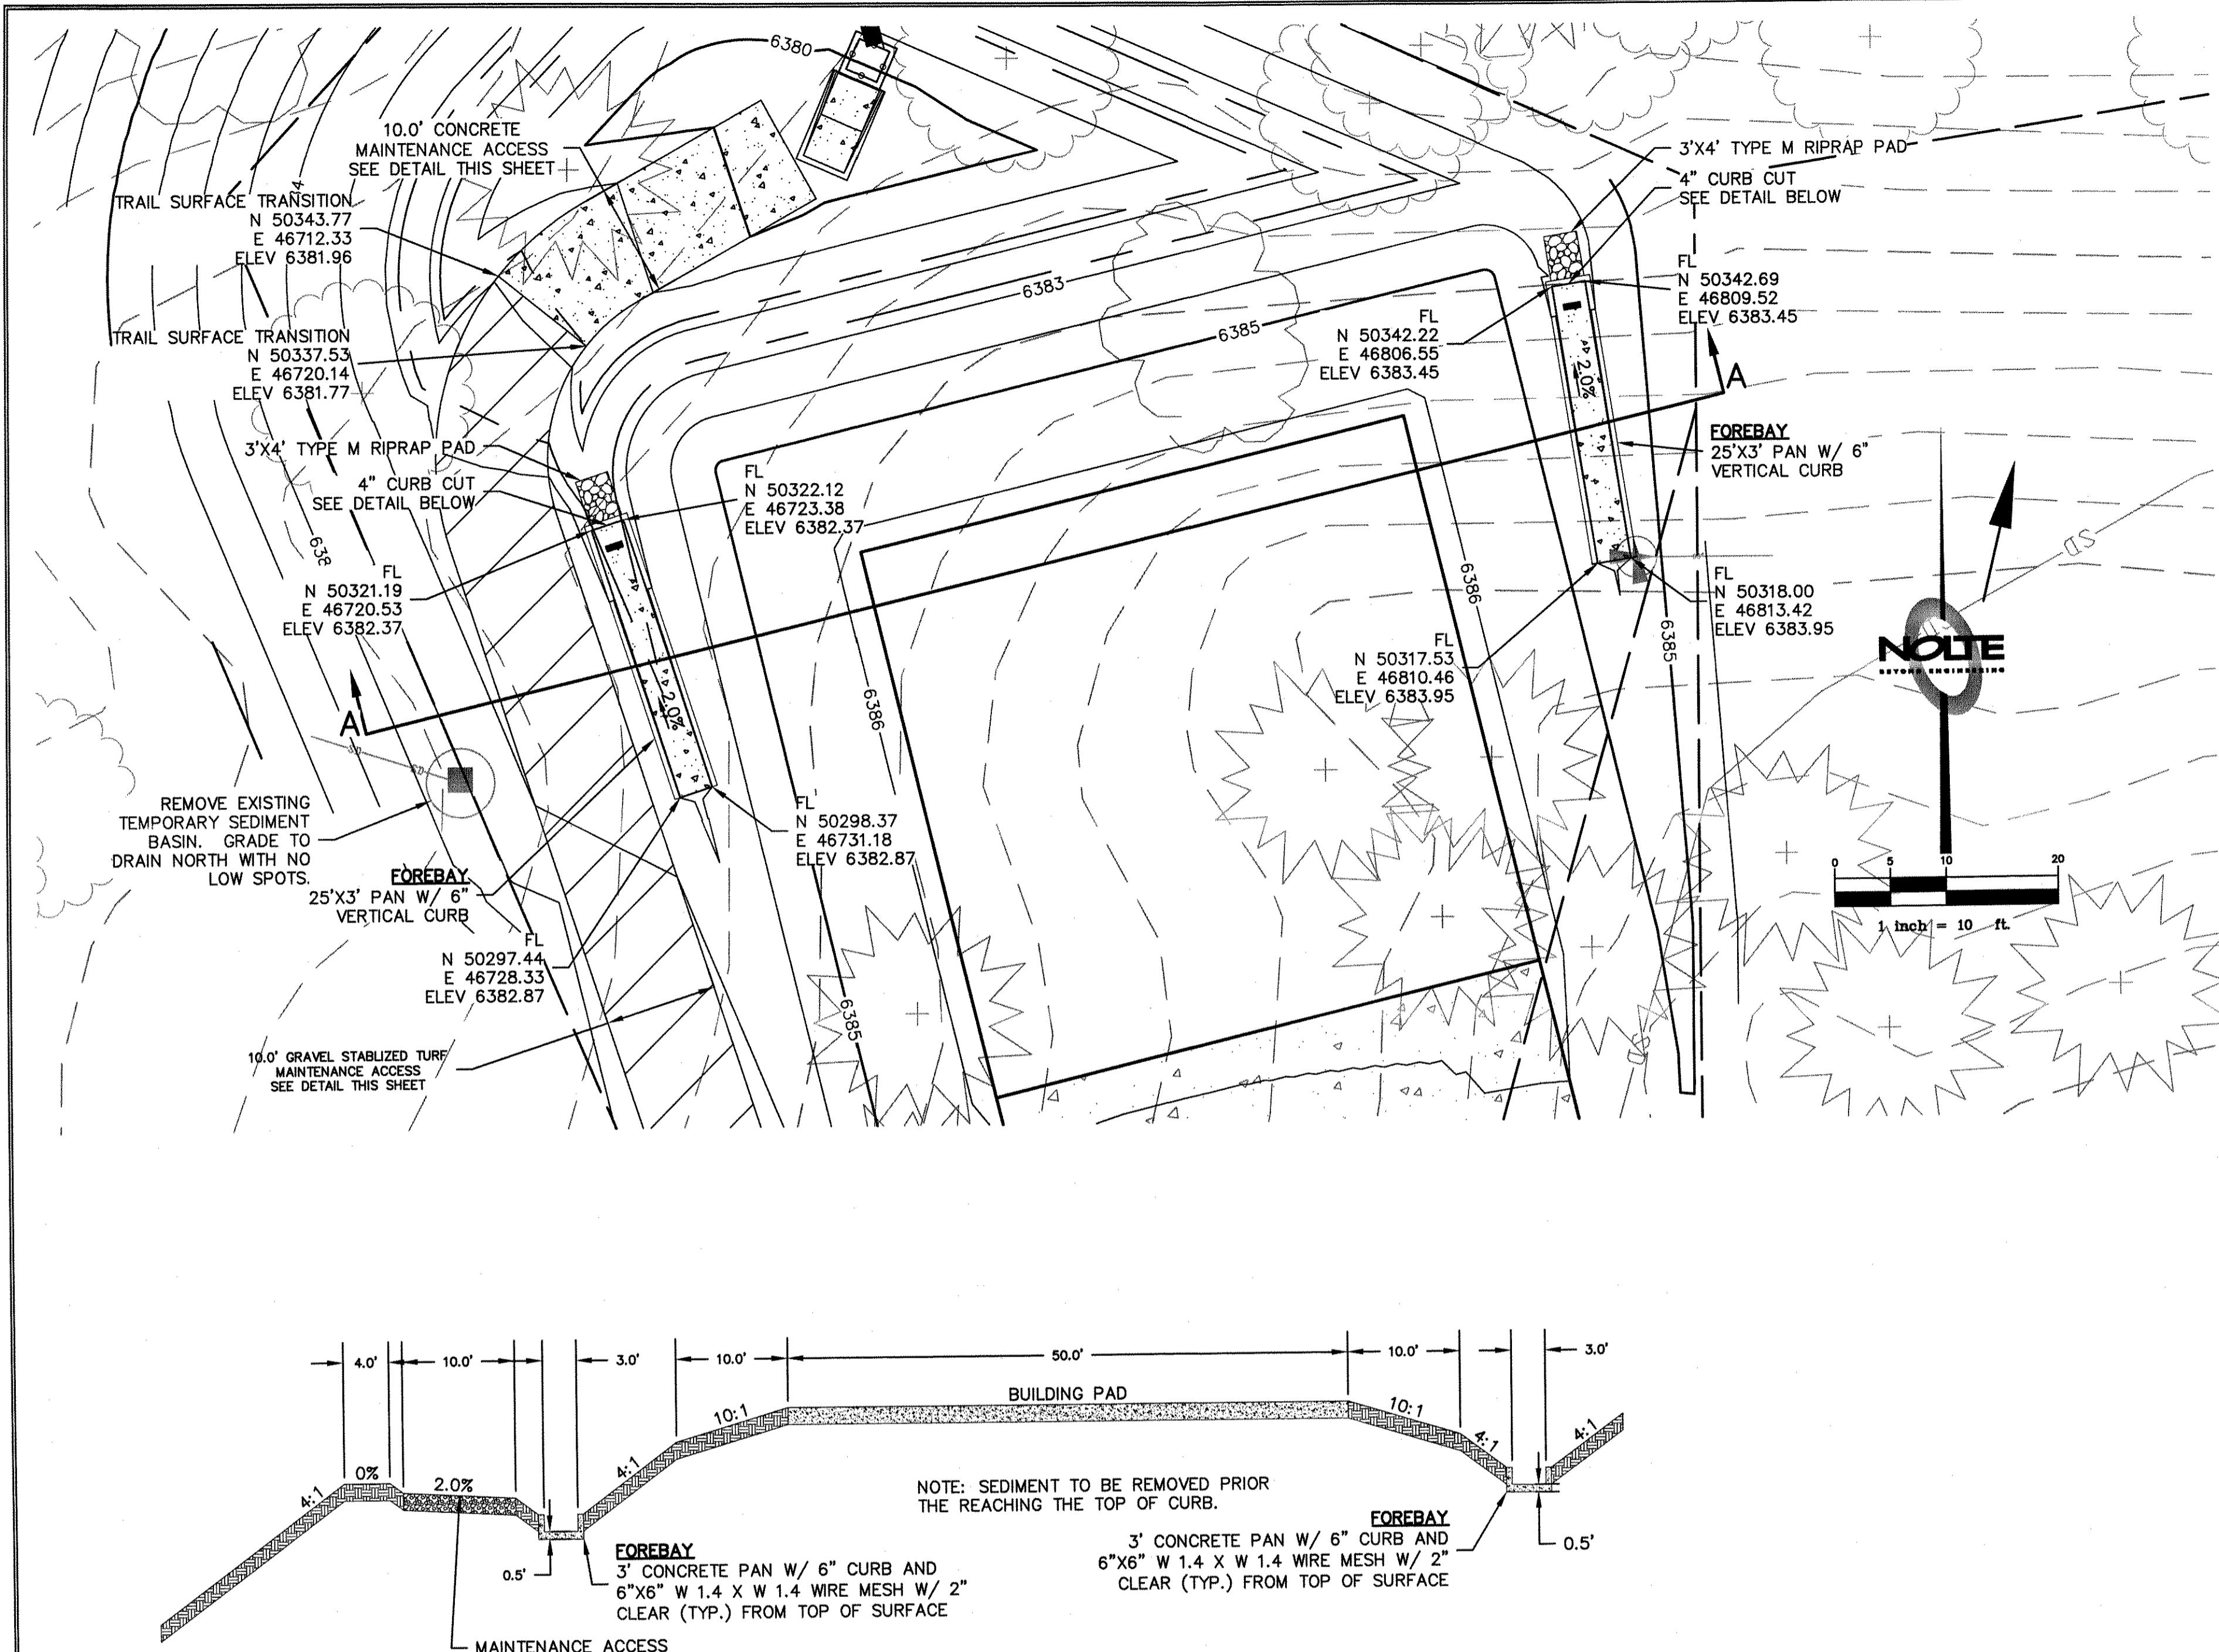


CROSS SECTION A-A

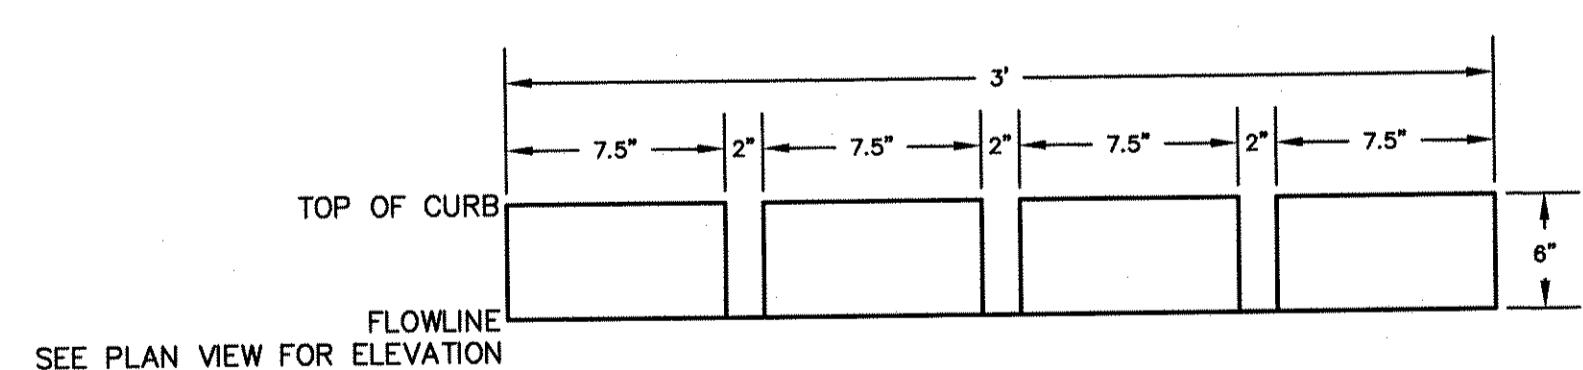

CURB CUT DETAIL

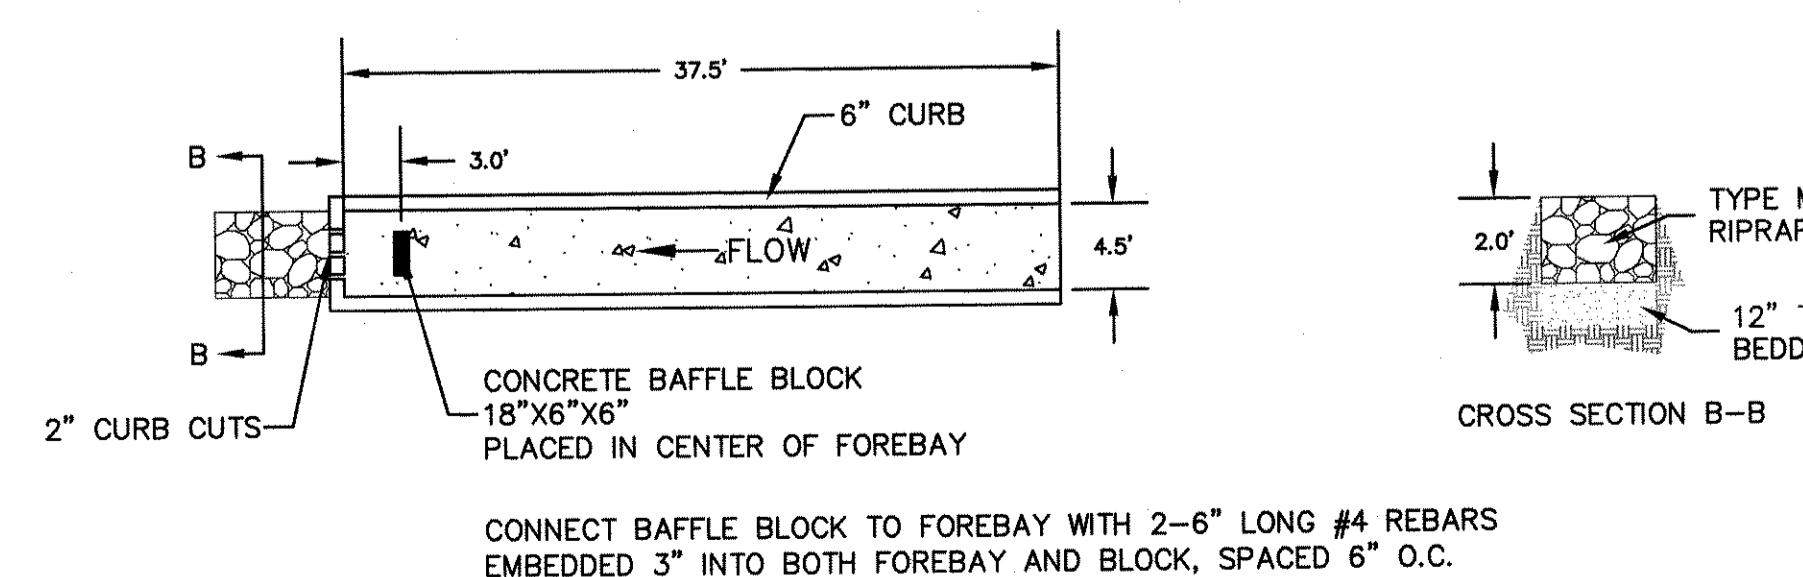


FOREBAY DETAIL

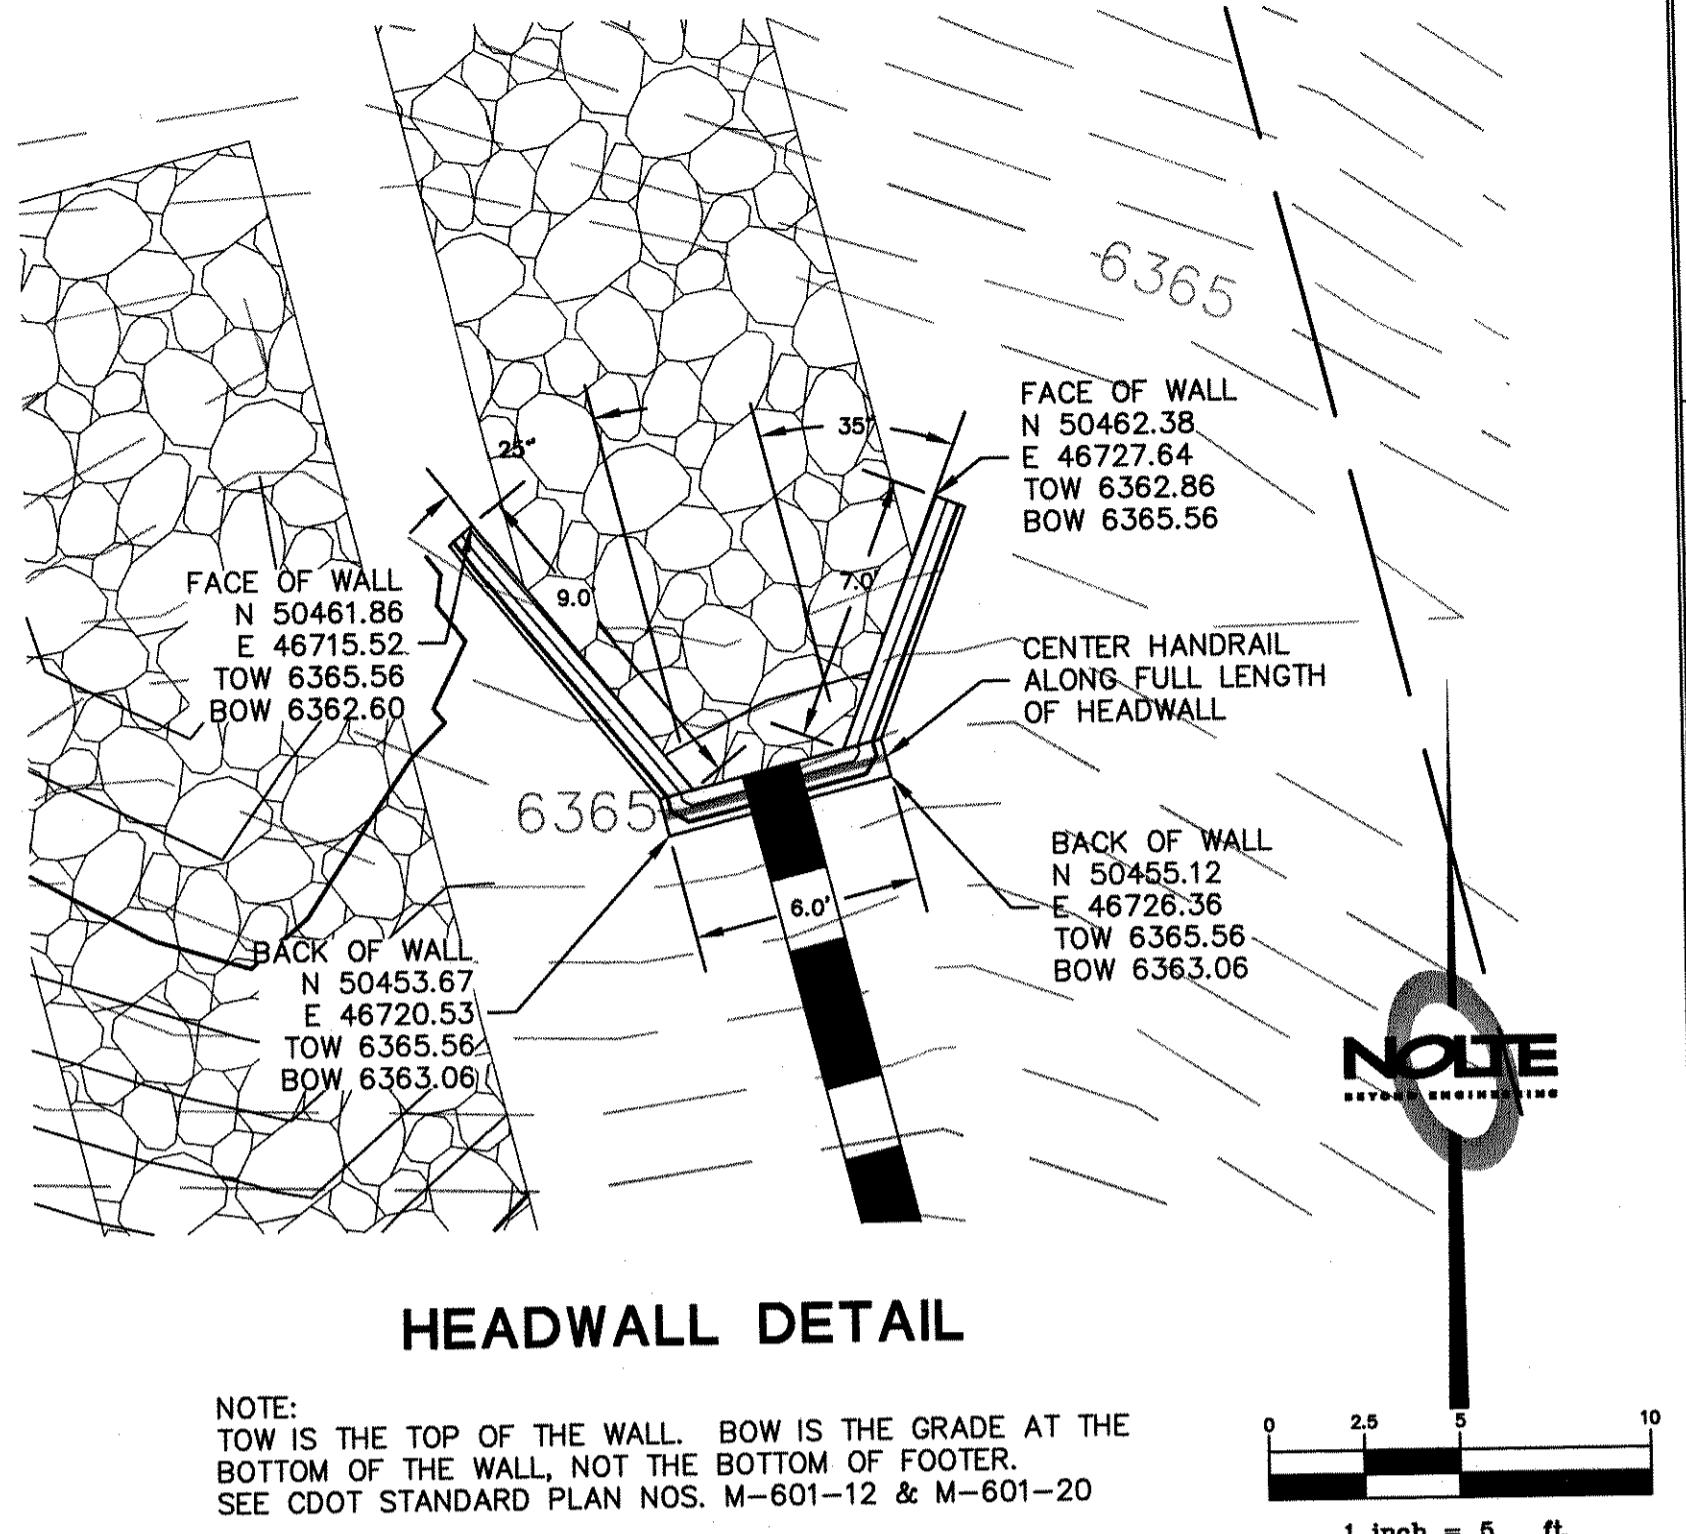

HEADWALL DETAIL


NOTE:
TOW IS THE TOP OF THE WALL. BOW IS THE GRADE AT THE
BOTTOM OF THE WALL, NOT THE BOTTOM OF FOOTER.
SEE CDOT STANDARD PLAN NOS. M-601-12 & M-601-20

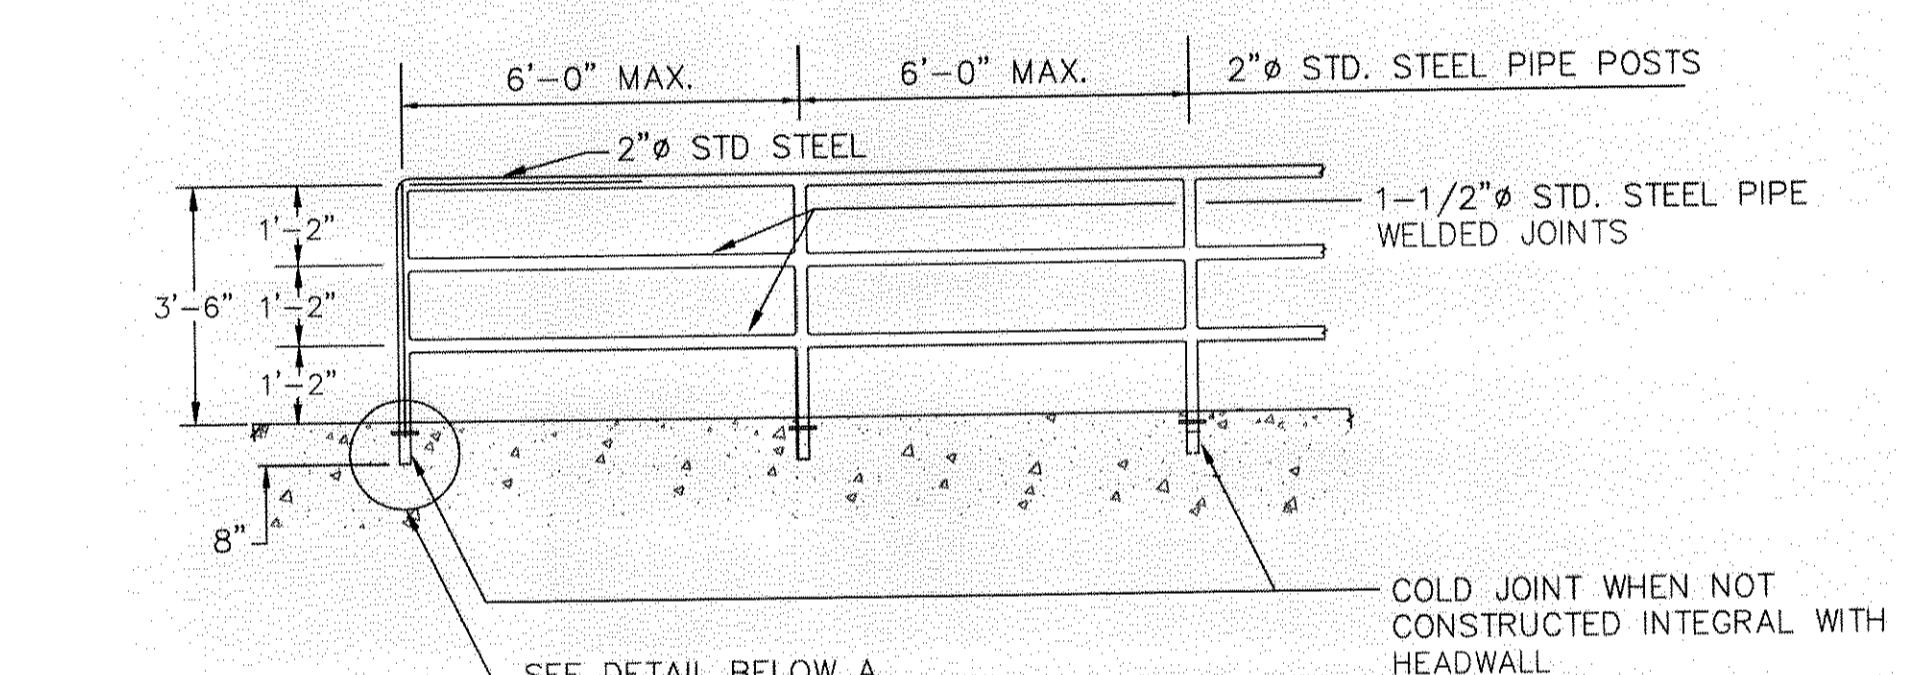


LD JOINT WHEN NOT
INSTRUCTED INTEGRAL WITH
ADWALL

NOTES:

1. RAILING SHALL BE HOT DIP GALVANIZED AFTER FABRICATION.
2. ALL POSTS SHALL BE PLUMB AND RAILS PARALLEL TO TOP OF WALL.
3. PIPE MATERIAL SHALL CONFORM TO ASTM A53.

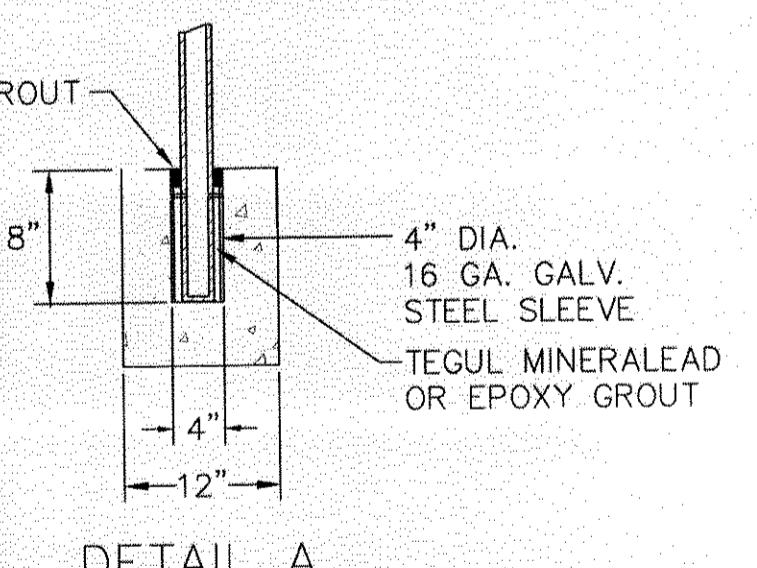

ANDRAIL DETAIL

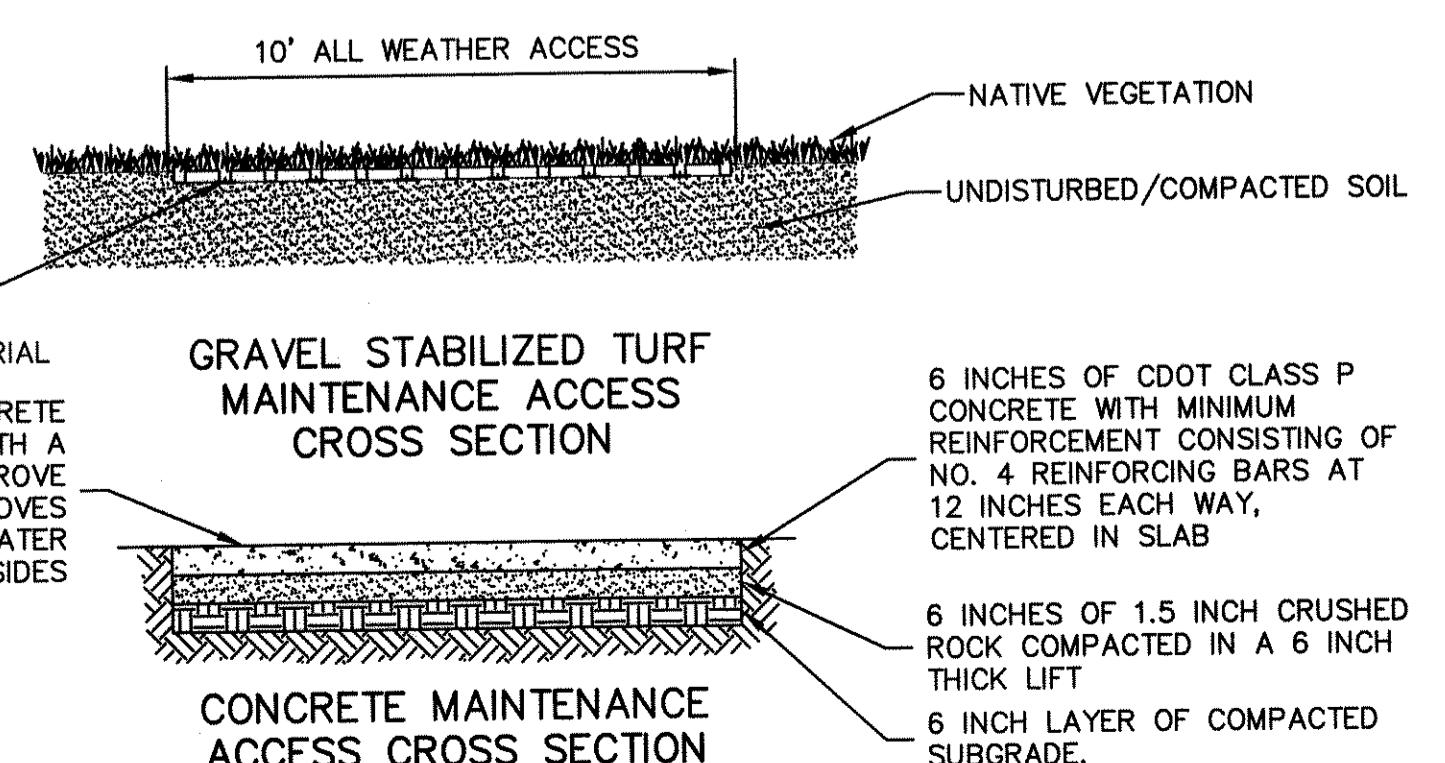

THE ONE %

B E Y O N D E N G I N E E R I N G
S. S. Chester Street, Suite 200
303.220.9001 FAX
20206400 TEL
Centennial, CO 80112
WWW.NOLTE.COM

A circular stamp with a rope-like border. The words "COLORADO REGISTERED" are at the top and "PROFESSIONAL ENGINEER" are at the bottom. In the center, it says "37642" above "3-26-08". There is a large "A" on the right side.

SHEET NUMBER
BB8

OF 7 S

OF 7 SHEETS
JOB NUMBER
DV131005

the preparer of these plans.

PREPARED FOR: HIGH PRAIRIE FARMS METRO DISTRICT
Terminal, 33 3312
WWW.NOLTE.COM

SOUTH METRO FIRE RESCUE

FIRE MARSHAL'S OFFICE



Carolyn Washee-Freeland, AICP, Senior Planner
Douglas County Department of Community Development, Planning Services
100 Third St
Castle Rock Co 80104
303.660.7460
303.660.9550 Fax

Project Name: High Prairie Farms Metro District – Location and Extent
Project File #: **LE2024-027**
S Metro Review #: REFSP24-00195

Review date: November 14, 2024

Plan reviewer: Aaron Miller
720.989.2246
aaron.miller@southmetro.org

Project Summary: High Prairie Farms Metro District requests approval of a Location and Extent for the construction of a new maintenance building located near the northeast corner of S. Pinery Pkwy and Democrat Road SPN: 2347-182-05-001.

Code Reference: Douglas County Fire Code, 2018 International Fire Code, and 2021 International Building Code with amendments as adopted by Douglas County.

South Metro Fire Rescue (SMFR) has reviewed the provided documents and has no objection to the proposed Location and Extent. Applicants and Contractors are encouraged to contact SMFR regarding the applicable permit requirements for the proposed project.



Right of Way & Permits

1123 West 3rd Avenue
Denver, Colorado 80223
Telephone: 303.285.6612
violeta.ciocanu@xcelenergy.com

November 18, 2024

Douglas County Planning Services
100 Third Street
Castle Rock, CO 80104

Attn: Carolyn Washee-Freeland

**Re: Pinery Filing 30A, Tract F, High Prairie Farms MetroDistrict - New Maintenance Building Location and Extent Request
Case # LE2024-027**

Public Service Company of Colorado's (PSCo) Right of Way & Permits Referral Desk has reviewed the documents for **the above-mentioned project** and currently has **no apparent conflict**.

As a safety precaution, PSCo would like to remind the developer to call the Utility Notification Center by dialing 811 for utility locates prior to construction.

Violeta Ciocanu (Chokanu)
Right of Way and Permits
Public Service Company of Colorado dba Xcel Energy
Office: 303-285-6612 – Email: violeta.ciocanu@xcelenergy.com

From: annb cwc64.com <annb@cwc64.com>
Sent: Wednesday, November 13, 2024 2:31 PM
To: Carolyn Freeland
Cc: Pam Choy (pc2914@att.com); duanew cwc64.com; jt cwc64.com
Subject: Democrat Road Franktown, Colorado Douglas County eReferral #LE2024-027
Attachments: Democrat Road Franktown, Colorado.jpg

Hi Carolyn,

This is in response to your eReferral with a utility map showing any buried AT&T Long Line Fiber Optics near Democrat Road Franktown, Colorado. The Earth map shows the project area in red. Based on the address and/or map you provided, there should be NO conflicts with the AT&T Long Lines, as we do not have facilities in that area.

Please feel free to contact us with any questions or concerns.

Ann Barnowski
Clearwater Consulting Group Inc
120 9th Avenue South
Suite 140
Nampa, ID 83651
AnnB@cwc64.com

The attached google earth maps are intended to show approximate locations of the buried AT&T long line fiber optic cable. The maps are provided for informational purposes only. In no way should the maps be used for anything other than general guidelines as to where the fiber is or is not and any other use of these maps is strictly prohibited.

-----Original Message-----

From: cfreeland@douglas.co.us <cfreeland@douglas.co.us>
Sent: Tuesday, November 12, 2024 2:39 PM
To: annb cwc64.com <annb@cwc64.com>
Subject: Douglas County eReferral (LE2024-027) Is Ready For Review

There is an eReferral for your review. Please use the following link to log on to your account:
<https://apps.douglas.co.us/planning/projects/Login.aspx>


LE2024-027, Pinery Filing 30A, Tract F, High Prairie Farms MetroDistrict - New Maintenance Building Location and Extent Request

High Prairie Farms Metro District requests approval of a Location and Extent for the construction of a new maintenance building located near the northeast corner of S. Pinery Pkwy and Democrat Road SPN: 2347-182-05-001.

This referral will close on November 26, 2024.

If you have any questions, please contact me.

Sincerely,

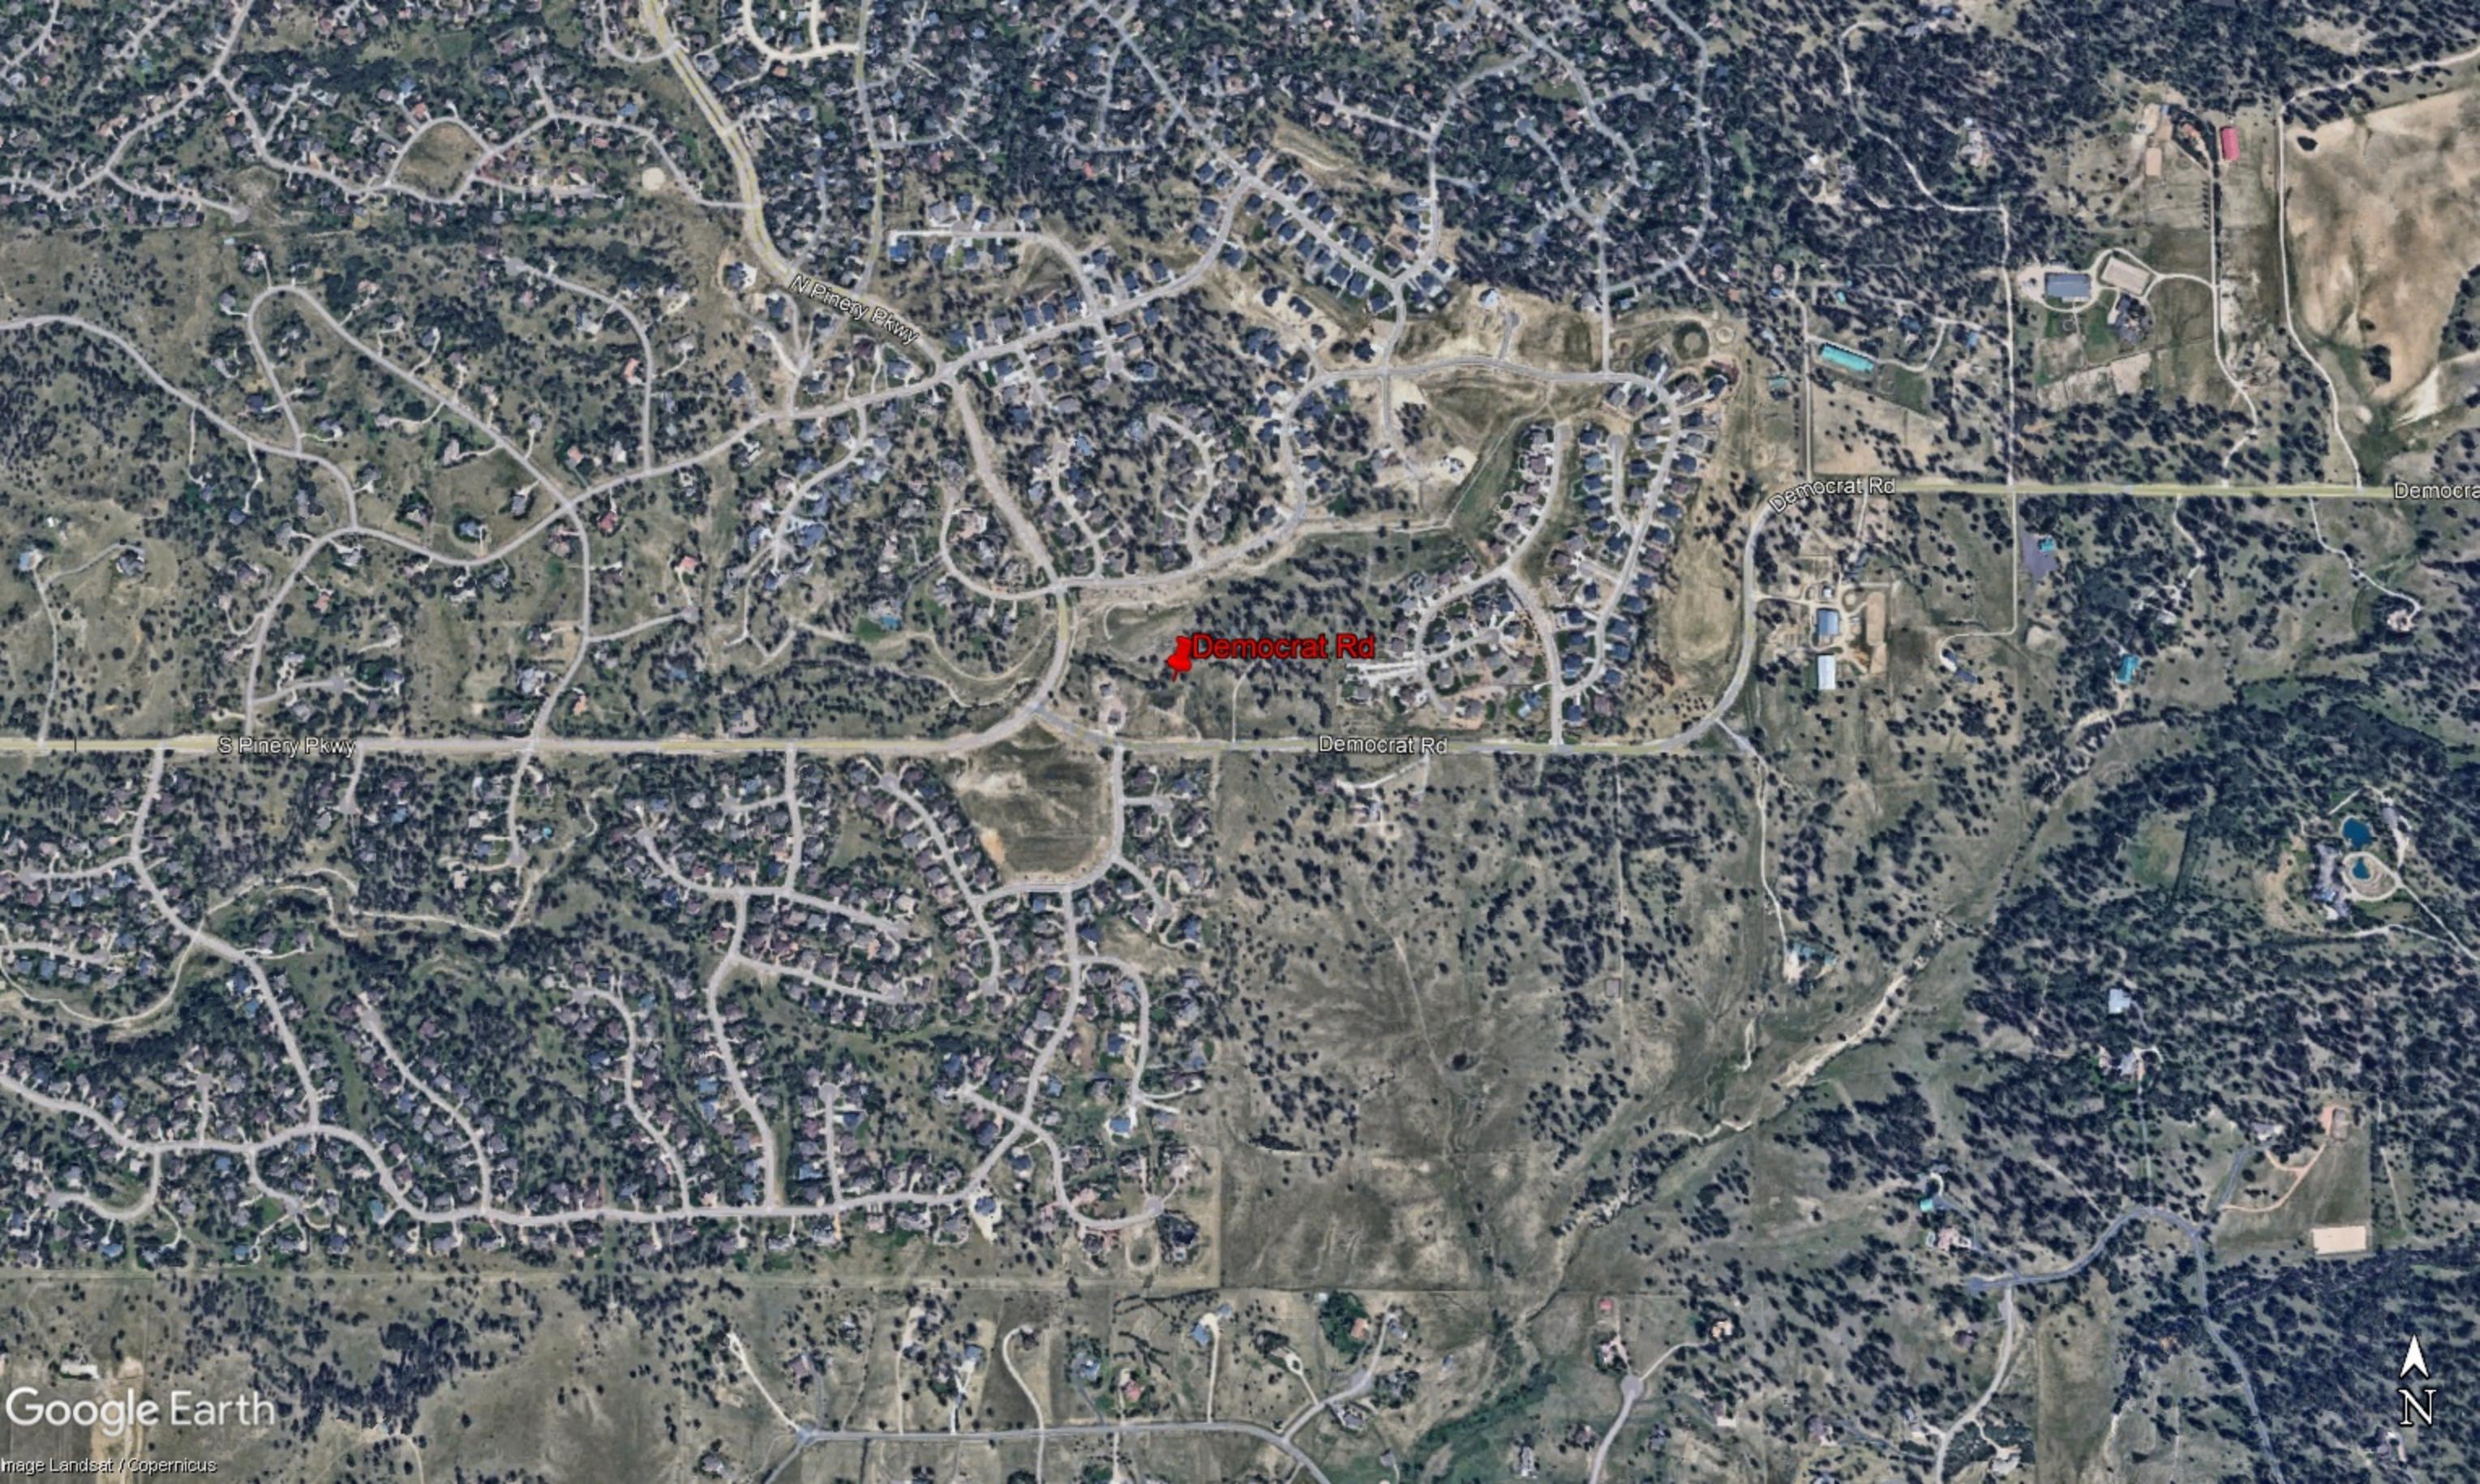

Google Earth

Image Landsat / Copernicus

N